IREDELL COUNTY HEALTH DEPARTMENT

This permit voids previously issued permit dated 9/27/01

STATESVILLE 704-878-5305 CI MOORESVILLE 704-664-5281

IMPROVEMENT PERMIT / AUTHORIZATION TO CONSTRUCT / OPERATION PERMIT / EXISTING SYSTEM INSPECTION

PERMIT# 101199 PIN# ~~4710-69-3384~~ 68-2819 DATE 11/9/04

OWNER OR CONTRACTOR Jeff McIntyre PHONE: Business (336) 476-3646 Home (336) 766-9549

ADDRESS 6001 Shea Meadows Clemmons, N.C. 27012

LOCATION Buffalo Shoals Rd, (L) Laurel Cove (L) Island Terrace (L) River Ridge on Left

SUBDIVISION River Ridge BLOCK / SECTION - LOT 4 LOT AREA 1.21 Ac SITE CLASS. RS DESIGN FLOW 360gpd L.T.A.R. .30gpd/ft²

Septic Tank: 1,000 Gallons; STB 1012 Date 12-1-03

Pump Tank: 1,000 Gallons; PT 17 Date 11-18-03

Pump Make: Goulds Model WE 1012 H Serial No. C04527976

Nitrification Field: No Fields 1 Square Feet ~~1,200~~ 1200 Linear Feet 200

No Lines 4@50' Trench Width 24" Max Trench Bottom Depth 36" Gravel Depth NA

☒ New System ☐ Repair System Type: I, II, ☒ III, IV, V, VI

System Description: Pump, Panel

Repair System Description: Pump, Panel

Maintenance Agreement Required: ☐ Yes ☒ No

☒ House/Mod. Home ☐ Mobile Home ☐ Business ☐ Other

No. Bedrooms 3 No. Bathrooms 2 No. Employees ___

☐ Slab ☐ Crawl Space ☒ Basement w/plumbing ☐ Basement wo/plumbing

Water Supply: ☒ Individual ☐ Public ☐ Community

Comments:/Conditions: ① Attachments "A" & "B" are part of this permit

② ③ Install 44 panels w/ 33 tons of sand


Comments:/Conditions: Tuff-Tite & Filter ST marker Installed

two lines checked 5/19; two lines checked 5/20;


Pressure Check Okay, inf

Et A-Okay 8/31/04

INITIAL SITE SKETCH

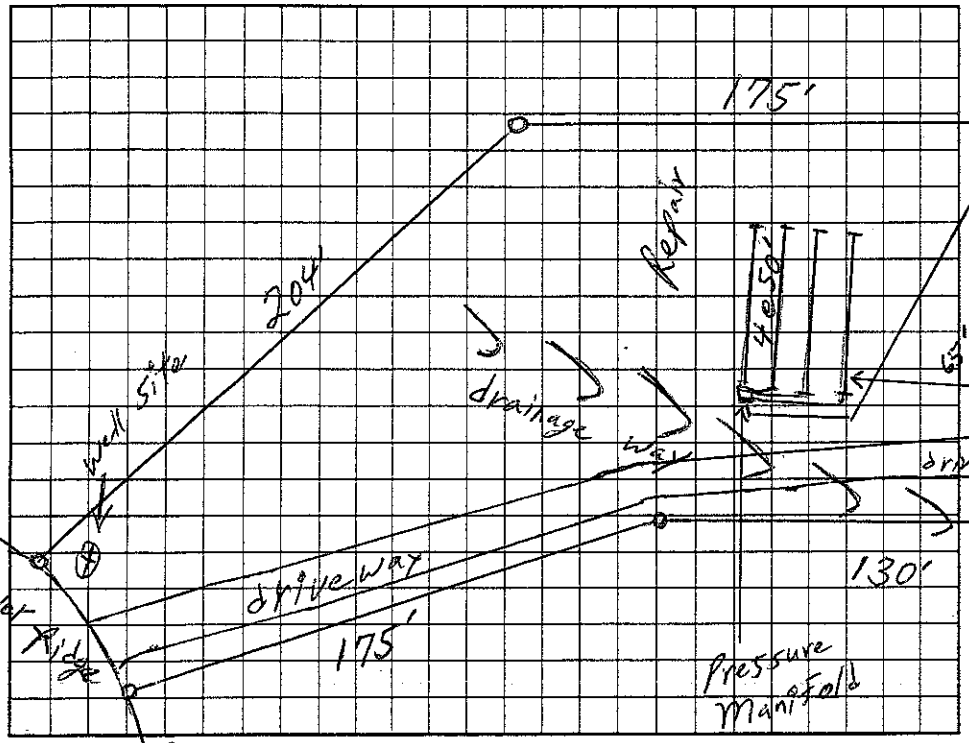

AS BUILT SKETCH

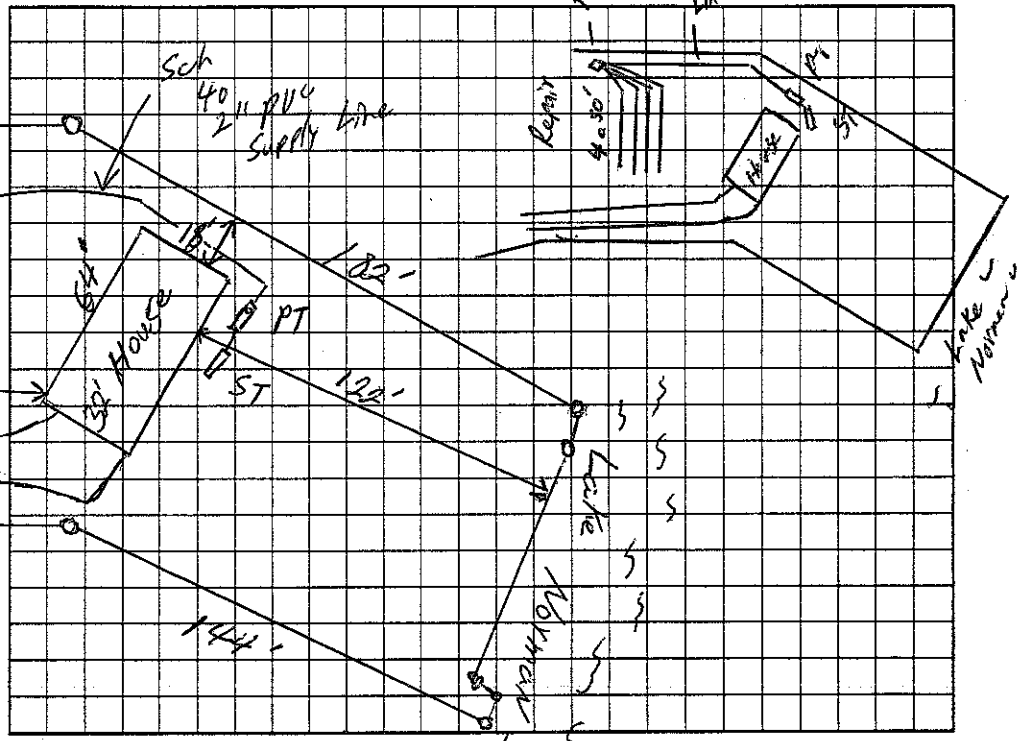

Permit can be suspended or revoked if any false information is supplied toward securing the permit/any unauthorized changes are made to the site/any unauthorized changes are made in the installation of the system. Improvement Permit with plat valid without expiration. Improvement Permit with site plan valid for sixty months. Authorization to Construct is valid for a period equal to that of Improvement Permit – not to exceed sixty months.

Signed: John P. McIntyre date Jan 13, 04

Improvement Permit by: William O. Johnson date 1/9/04

Authorization to Construct by: William O. Johnson date 1/9/04

Installed by: Tommy Frye

Operation Permit by: William O. Johnson date 8-31-04

Existing System Inspection by: ___ date ___

HEALTH DEPT. COPY: WHITE OWNER COPY (FINAL): YELLOW OWNER COPY (INITIAL): PINK