Not on call Book -

IREDELL COUNTY HEALTH DEPARTMENT

Statesville Phone TR 3-7271 Mooresville Phone NO 3-1271

PERMIT TO INSTALL SEPTIC TANK

Permit NO. _____ Permit Date July 25 1973

Owner Earl Carnie Address Spring Shore -

Installed By Robert Hoke Address Statesville NC


Location of Property Lake Norman

Tank		Capacity		Length of Lines		Fixtures	
Block	( )	1000	( )	225'	( )	No. of Baths	( )
Precast	( )	1250	( )	250'	( )	Dishwasher	( )
		1500	( )	Other 150 ft		Garbage Grdr.	( )
		Other				Other	

NOTIFY HEALTH DEPARTMENT AT LEAST EIGHT HOURS BEFORE TANK IS TO BE INSPECTED.

Final Inspection _____ 19__ Approved (✓) Disapproved ( )

Remarks Repair 150 ft line added

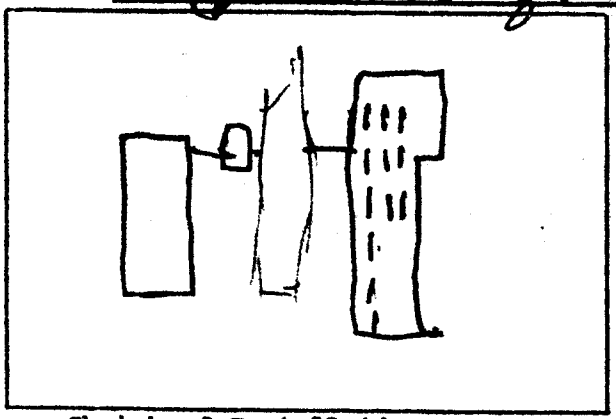

Sketch of Installation

R W Johnson R.S.

Sanitarian