IREDELL COUNTY HEALTH DEPARTMENT

Statesville Phone TR 3-7271 — Mooresville Phone NO 3-1271

PERMIT TO INSTALL SEPTIC TANK

Permit No. 331 — Permit Date _____ 19__

Owner Earl Carney — Address _____

Installed By Harlee Lackey — Address _____


Location of Property Spring Shores Development. Lot # 208 (?) 1st rd to right; then second left. At water front.

Tank		Capacity		Length of Lines		Fixtures	
Block	( )	1000	( )	225'	( )	No. of Baths	(3)
Precast	(✓)	1250	(✓)	250'	( )	Dishwasher	(/)
		1500	( )	Other 380'		Garbage Grdr.	(/)
		Other _____				Other _____	

NOTIFY HEALTH DEPARTMENT AT LEAST EIGHT HOURS BEFORE TANK IS TO BE INSPECTED.

Final Inspection 11-5-1971 — Approved (✓) Disapproved ( )

Remarks Stubout 5 feet deep. Tank 6 feet deep. Lines 6' deep at tank. Laid out by R.N.J. Central water supply

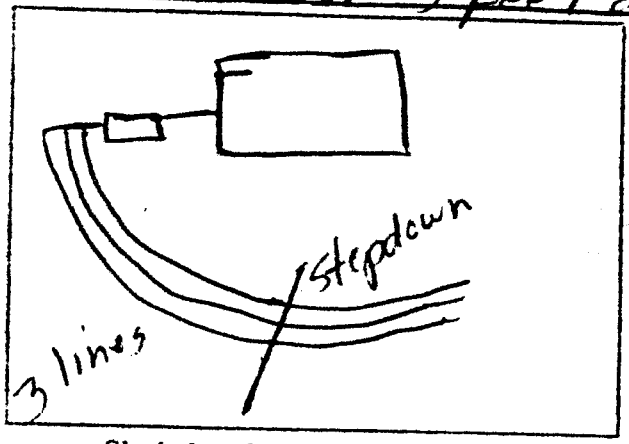

Sketch of Installation

Sanitarian