IREDELL COUNTY HEALTH DEPARTMENT

CI STATESVILLE 704-878-5305 MOORESVILLE 704-664-5281

IMPROVEMENT PERMIT / AUTHORIZATION TO CONSTRUCT / OPERATION PERMIT / EXISTING SYSTEM INSPECTION

PERMIT# 126013 PIN# 4710-69-5345 14 BOB WILSON LARS EVERSOLE DATE 2-24-05

OWNER OR CONTRACTOR JOSEPH BERTUCCIO PHONE: Business 704-304-3987/704-363-4615 Home 704-622-3544 / 631-471-4206

ADDRESS 6 LAYTON LANE, CENTER REACH, NY 11720

LOCATION BUFFALO SHOALS (L) LAUREL COVE (L) ISLAND TERRACE (R) LEFT 154 RIVER RIDGE LN

SUBDIVISION RIVERRIDGE BLOCK / SECTION LOT 8 LOT AREA 4.45AC SITE CLASS. PS DESIGN FLOW 360 L.T.A.R. .3

Septic Tank: 1000 Gallons; STB 794 Date 1-31-05
Pump Tank: 1000 Gallons; PT PT 27 Date 7-1-05
Pump Make: GOULDS Model WE01B12H Serial No. C053792 34
Nitrification Field: No Fields 1 Square Feet @ D=1.00 Linear Feet 300'
No Lines 6X50' Trench Width 36" Max Trench Bottom Depth 36" Gravel Depth N/A

[X] New System [ ] Repair System Type: I, II, [III], IV, V, VI
System Description: PUMP 25% REDUCT
Repair System Description: LP 50% REDUCT
Maintenance Agreement Required: [ ] Yes [X] No

[X] House/Mod. Home No. Bedrooms 3
[ ] Mobile Home No. Bathrooms 3
[ ] Business No. Employees
[ ] Other


Water Supply: [X] Individual [ ] Public [ ] Community

[ ] Slab [ ] Crawl Space [X] Basement w/plumbing [ ] Basement wo/plumbing


Comments:/Conditions: (1) KEEP SYSTEM 15' OFF CUT EMBANKMENT (2) SYSTEM IS FLAGGED & SOGGED IN. (3) INSTALL 6 LINES 50' LONG SPLITTED INTO MIDDLE USING A PRESSURE MANIFOLD (4) FOLLOW PROPER RULES FOR DRIVEWAY

Comments:/Conditions: CROSSINGS. (5) INSTALL LINES ON CONTOURS & MAINTAIN SETBACKS. (6) CALL PRIOR TO INSTALLATION FOR PUMP SIZING & SYSTEM SPECS IF NECESSARY.

INITIAL SITE SKETCH

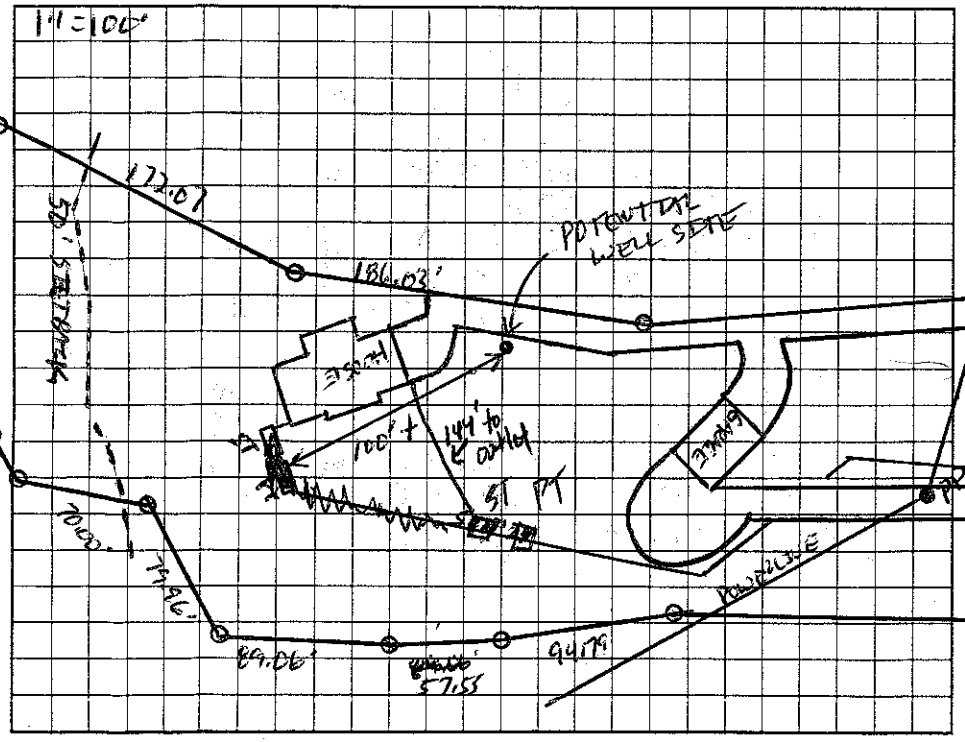

AS BUILT SKETCH

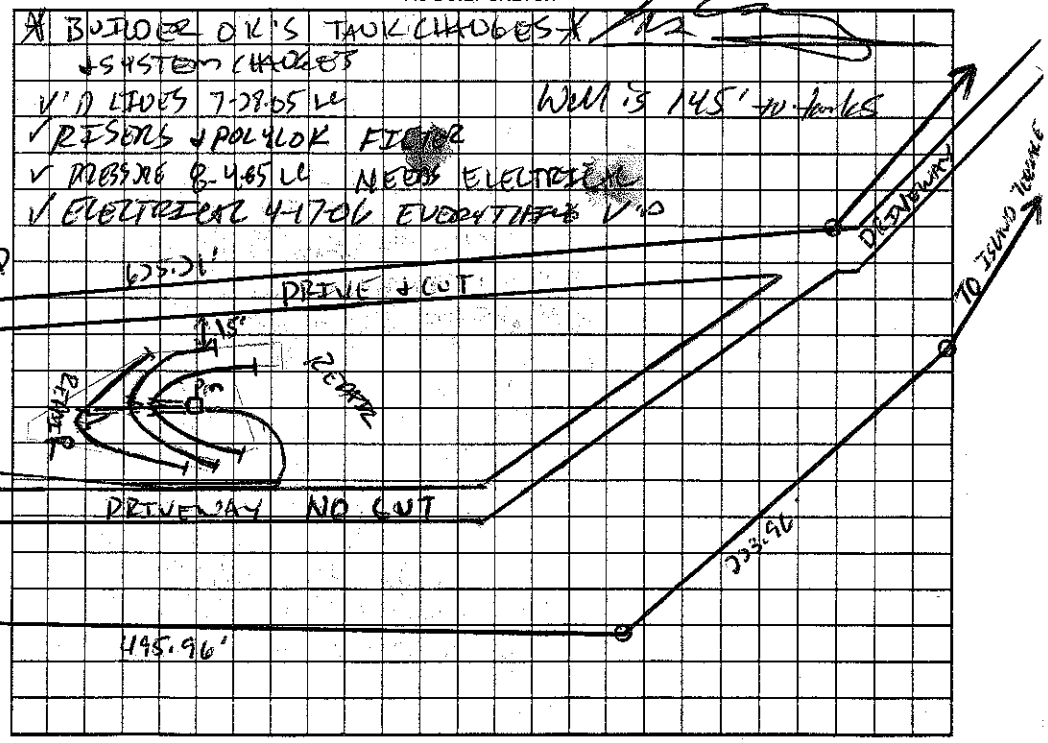

Permit can be suspended or revoked if any false information is supplied toward securing the permit/any unauthorized changes are made to the site/any unauthorized changes are made in the installation of the system. Improvement Permit with plat valid without expiration. Improvement Permit with site plan valid for sixty months. Authorization to Construct is valid for a period equal to that of Improvement Permit – not to exceed sixty months.

Signed: _____ date 2-24-05 Installed by: CURT DUNDAWAY

Improvement Permit by: _____ date 2-24-05 Operation Permit by: _____ date 4-17-06

Authorization to Construct by: _____ date 2-24-05 Existing System Inspection by: _____ date _____

HEALTH DEPT. COPY: WHITE OWNER COPY (FINAL): YELLOW OWNER COPY (INITIAL): PINK