Statesville Phone TR 3-7271 Mooresville Phone No. 664-5281

PERMIT TO INSTALL SEPTIC TANK

Permit No. 73 Permit Date 11-15 1972

Bldr
Owner Rick Dyson Address Statesville, NC

Installed By Robert Hoke Address Statesville, NC

Location of Property Spring Shore


Lot # 16

Tank		Capacity		Length of Lines		Fixtures	
Block	( )	1000	( )	225'	( )	No. of Baths	(3)
Precast	(✓)	1250	(✓)	250'	( )	Dishwasher	( )
		1500	( )	Other 270		Garbage Grdr.	( )
		Other				Other	

NOTIFY HEALTH DEPARTMENT AT LEAST EIGHT HOURS BEFORE TANK IS TO BE INSPECTED.

Final Inspection 11-15 1972 Approved (✓) Disapproved ( )

Remarks Community Water Supply

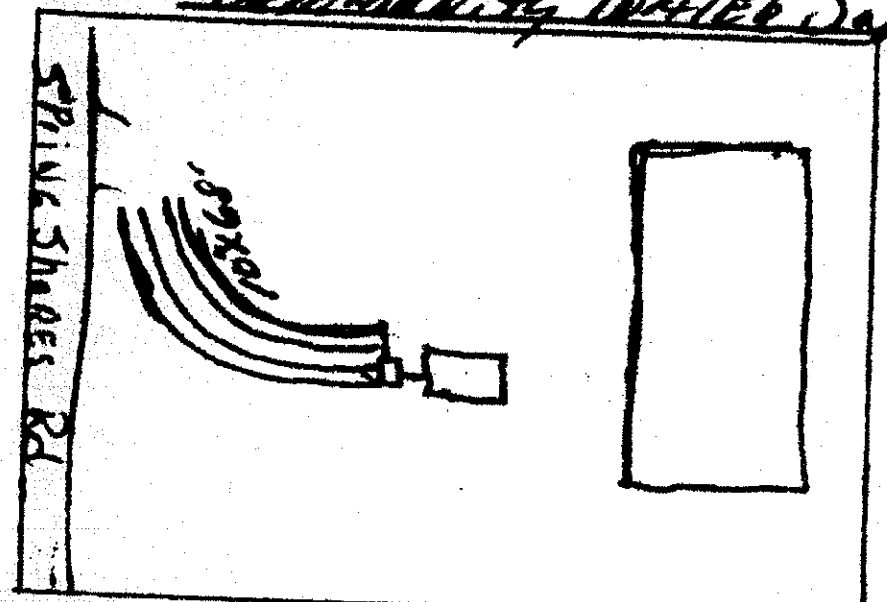

Sketch of Installation

Glenn Todd