IREDELL COUNTY HEALTH DEPARTMENT

Statesville Office (704) 878-5305 | Mooresville Office (704) 660-3625 PERMIT # 209757

IMPROVEMENT PERMIT / AUTHORIZATION TO CONSTRUCT / OPERATION PERMIT / EXISTING SYSTEM

PIN # 4710 779919

APPLICANT: Penny London APPLICANT ADDRESS: 161 Spring Shore Rd Statesville NC

SITE ADDRESS: 161 Spring Shore Rd Statesville NC PHONE: 704-775-3309 ALT. PHONE: N/A

SITE DIRECTIONS: 215 (R) old Mtn Rd (L) E Monbo Rd (R) Pineville Rd (L) Spring Shore Rd Lot on left


SUBDIVISION: Spring Shore SECTION: N/A LOT # 16 + 16A LOT AREA: 0.74ac DESIGN FLOW: Ex L.T.A.R.: Ex

Septic Tank	Ex	(gal)	STB		Date		☐ New System ☐ Repair ☐ Expansion	System Type: I ☒ II III IV V VI	☒ Residence	No. Bedrooms	Ex	Water Supply
Pump Tank		(gal)	PT		Date		System Description:	Existing	☐ Business	No. Persons	Ex	☐ Private
Pump Make		Model			Serial #		Repair System Description:		☐ Other	No. Employees		☐ Public
# Nitrification Fields	Ex	# Lines	Ex		Linear Ft:	Ex	Maintenance Agreement Required:	☐ YES ☒ NO	☐ Slab	☒ Crawl Space		☒ Community
Trench Width	Ex	Max. Trench Bottom Depth	Ex		Gravel Depth	Ex	☒ GRAVITY	☐ PRESSURE	☐ Basement w/plumbing		☐ Basement w/o plumbing	

Comments / Conditions: All building foundations must be 35' from any part of STS.

INITIAL SITE SKETCH

AS BUILT SKETCH

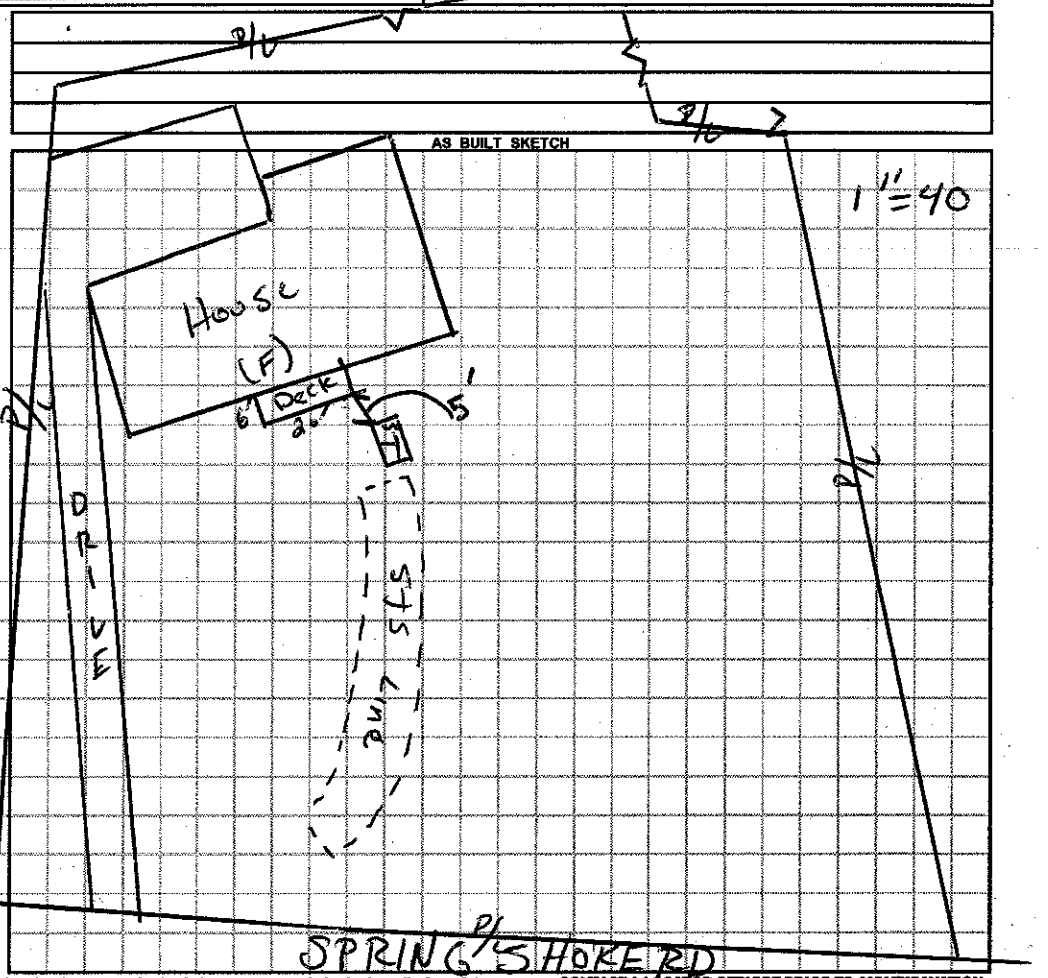

Permit can be suspended or revoked if any false information is supplied toward securing the permit / any unauthorized changes are made to the site / any unauthorized changes are made in the installation of the system. **CONTACT A LOCATOR SERVICE PRIOR TO ANY EXCAVATION**

☐ **IMPROVEMENT PERMIT** *with plat valid without expiration* ☐ **IMPROVEMENT PERMIT** *with site plan valid for 60 mos.* ☐ **AUTHORIZATION TO CONSTRUCT** *valid for period equal to IMPROVEMENT PERMIT--not to exceed 60 mo.*

Owner / Applicant Signature: Penny London Date: 4/28/15 Installed by:

IMPROVEMENT PERMIT by: Date: OPERATION PERMIT by: Date:

AUTHORIZATION TO CONSTRUCT by: Date: Existing System Inspected by: Robert H Shaw Date: 04/25/15

Health Dept. Copy - WHITE Applicant (Final Approval) - YELLOW Applicant (Conditional Approval) - PINK