IREDELL COUNTY HEALTH DEPARTMENT

Statesville Office (704) 878-5305 Mooresville Office (704) 660-3625 PERMIT # 176318

IMPROVEMENT PERMIT / AUTHORIZATION TO CONSTRUCT / OPERATION PERMIT / EXISTING SYSTEM

PIN # 4710-85-2199

APPLICANT: RANDALL SCHUETZ APPLICANT ADDRESS: 115 ISLAND RIDGE DR, STATESVILLE 28677

SITE ADDRESS: 1281 EAST MONBO ROAD, STATESVILLE 28677 PHONE: 704-528-8340 ALT. PHONE: 336-688-3640

SITE DIRECTIONS: OLD MOUNTAIN ROAD TO EAST MONBO ROAD, ON LEFT AT BOX #1281


SUBDIVISION: N/A SECTION: N/A LOT # N/A LOT AREA: 0.823 Ac DESIGN FLOW: 240 L.T.A.R.: EX

Septic Tank	EX	(gal)	STB		Date		☐ New System	☐ Repair	☐ Expansion	System Type: ☑ I ☐ II ☐ III ☐ IV ☐ V ☐ VI	☑ Residence	No. Bedrooms 2	Water Supply
Pump Tank		(gal)	PT		Date		System Description: CONVENTIONAL GRAVITY				☐ Business	No. Persons	☐ Private
Pump Make		Model			Serial #		Repair System Description:				☐ Other	No. Employees	☑ Public
# Nitrification Fields	1	# Lines			Linear Ft:	EX	Maintenance Agreement Required: ☐ YES ☑ NO				☐ Slab	☐ Crawl Space	☐ Community
Trench Width		Max. Trench Bottom Depth			Gravel Depth		☑ GRAVITY ☐ PRESSURE				☐ Basement w/plumbing		☐ Basement w/o plumbing

Comments / Conditions:

INITIAL SITE SKETCH

AS BUILT SKETCH

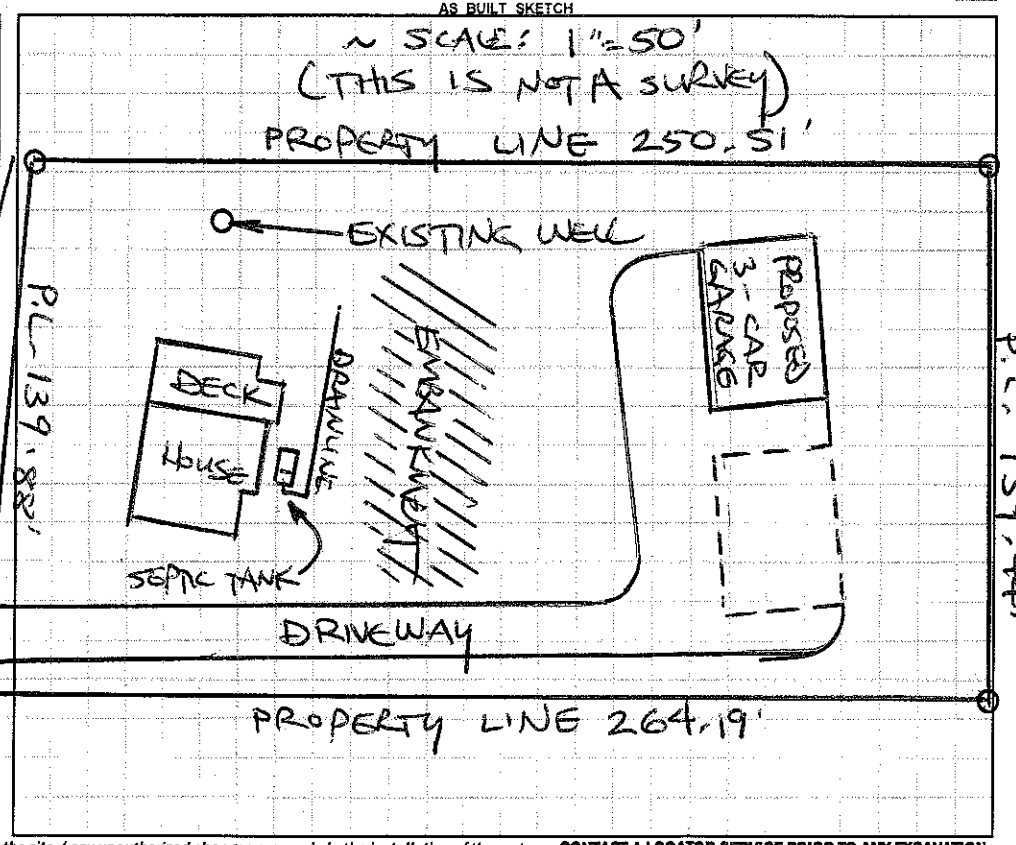

Permit can be suspended or revoked if any false information is supplied toward securing the permit / any unauthorized changes are made to the site / any unauthorized changes are made in the installation of the system. **CONTACT A LOCATOR SERVICE PRIOR TO ANY EXCAVATION**

☐ **IMPROVEMENT PERMIT** ***with plat*** *valid without expiration.* ☐ **IMPROVEMENT PERMIT** ***with site plan*** *valid for 60 mos.* ☐ **AUTHORIZATION TO CONSTRUCT** *valid for period equal to IMPROVEMENT PERMIT--not to exceed 60 mo.*

Owner / Applicant Signature: _____ Date: _____ Installed by: _____

IMPROVEMENT PERMIT by: _____ Date: _____ OPERATION PERMIT by: _____ Date: _____

AUTHORIZATION TO CONSTRUCT by: _____ Date: _____ Existing System Inspected by: STEVE HEDRICK Date: 1-7-13

Health Dept. Copy - WHITE Applicant (Final Approval) - YELLOW Applicant (Conditional Approval) - PINK