IREDELL COUNTY HEALTH DEPARTMENT

STATESVILLE 704-878-5305 (I) MOORESVILLE 704-664-5281

IMPROVEMENT PERMIT / AUTHORIZATION TO CONSTRUCT / OPERATION PERMIT / EXISTING SYSTEM INSPECTION

PERMIT# 9200612900 PIN# 4710-87-2886 DATE 12-20-05

OWNER OR CONTRACTOR WARREN NYE PHONE: Business 252-670-4252 Home 704-528-1845

ADDRESS 115 SPRING GROVE COURT Statesville NC 28677

LOCATION EAST NWBD @ PRUETTE @ Spring Stone @ Spring Stone Court 4th Lot on left in Cul de sac

SUBDIVISION Spring Stone BLOCK / SECTION ____ LOT 11 LOT AREA ____ SITE CLASS. PS DESIGN FLOW 360 L.T.A.R. .5

Septic Tank: 1000 Gallons; STB 312 Date 9-28-05
Pump Tank: 1000 Gallons; PT ____ Date 9-22-05
Pump Make: Goulds Model WE2511M Serial No. JD5752 90
Nitrification Field: No Fields ____ Square Feet 600 Linear Feet 206'
No Lines 6x34' Trench Width 36" Max Trench Bottom Depth 36" Gravel Depth N/A

☒ New System ☐ Repair System Type: I, II, III, IV, V, VI
System Description: PUMP 50% RED
Repair System Description: LPP 50% RED
Maintenance Agreement Required: ☐ Yes ☒ No


☒ House/Mod. Home No. Bedrooms 3
☐ Mobile Home No. Bathrooms 2
☐ Business No. Employees ____
☐ Other ____
☐ Slab ☐ Crawl Space ☐ Basement w/plumbing ☒ Basement wo/plumbing

Water Supply: ☐ Individual ☐ Public ☒ Community

Comments:/Conditions: GULLEYS MUST BE PROPERLY FILLED

Comments:/Conditions: SEPTIC TANK WITH MARKER & RISERS INSTALLED USING REP POLYLOK Filter - RSH - CALLED Steve Hendricks Pressure was set on the above visit BUT NO ELECTRICAL WAS DONE AT FIRST OF NOVEMBER

INITIAL SITE SKETCH

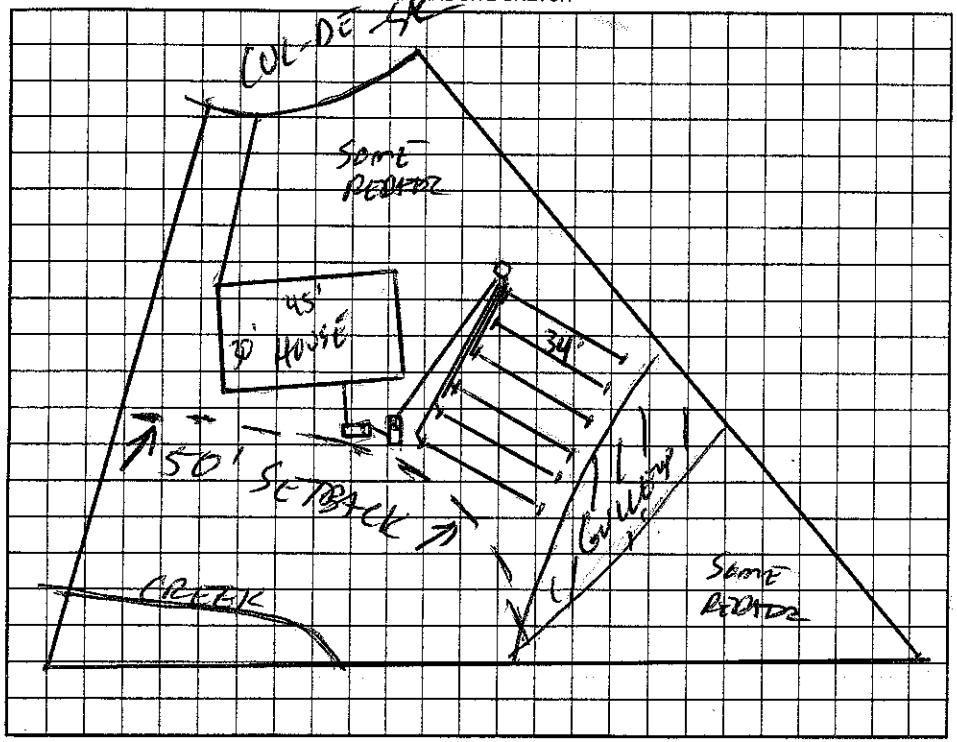

AS BUILT SKETCH

- V'D ELECTRICAL AFTER OWNER CAME IN AND PAID FOR NEW PERMIT. ORIGINAL HAD EXPIRED.
- 12-16-05 TURNED ON ELECTRICAL
- 12-19-05 TURNED ON ELECTRICAL
- 12-2005 ELECTRICAL V'D OK

Permit can be suspended or revoked if any false information is supplied toward securing the permit/any unauthorized changes are made to the site/any unauthorized changes are made in the installation of the system. Improvement Permit with plat valid without expiration. Improvement Permit with site plan valid for sixty months. Authorization to Construct is valid for a period equal to that of Improvement Permit – not to exceed sixty months.

Signed: W L date 12-20-05 Installed by: TURNER'S HAULING & GRADING

Improvement Permit by: [signature] date 12-20-05 Operation Permit by: [signature] RS date 12-20-05

Authorization to Construct by: [signature] date 12-20-05 Existing System Inspection by: ____ date ____

HEALTH DEPT. COPY: WHITE OWNER COPY (FINAL): YELLOW OWNER COPY (INITIAL): PINK