IREDELL COUNTY HEALTH DEPARTMENT

Statesville Office (704) 878-3305 Mooresville Office (704) 660-3625 PERMIT # 202269

IMPROVEMENT PERMIT / AUTHORIZATION TO CONSTRUCT / OPERATION PERMIT / EXISTING SYSTEM

PIN # 4710881131

APPLICANT: Elizabeth Beasley APPLICANT ADDRESS: 147 Spring Shore Rd Statesville NC 28677

SITE ADDRESS: 147 Spring Shore Rd Statesville NC 28677 PHONE: 704-466-7784 ALT. PHONE: N/A

SITE DIRECTIONS: E Monbo to Pineville L on Spring Shore House on left


SUBDIVISION: Spring Shore SECTION: N/A LOT # 14 LOT AREA: .4ac DESIGN FLOW: EX L.T.A.R.: EX

Septic Tank	1000 (gal)	STB	2071-1060	Date	N/A	☐ New System	☒ Repair	☐ Expansion	System Type: I II III IV V VI
Pump Tank	N/A (gal)	PT	N/A	Date	N/A	System Description:	Tank Replacement		
Pump Make	N/A	Model	Polylok	Serial #	PL-68	Repair System Description:	N/A		
# Nitrification Fields	1	# Lines	EX	Linear Ft:	EX	Maintenance Agreement Required:	☐ YES	☒ NO	
Trench Width	EX	Max. Trench Bottom Depth	EX	Gravel Depth	EX		☒ GRAVITY	☐ PRESSURE	

☒ Residence	No. Bedrooms	EX	Water Supply	
☐ Business	No. Persons	EX	☐ Private	
☐ Other	No. Employees	EX	☐ Public	
☐ Slab	☒ Crawl Space		☒ Community	
☐ Basement w/plumbing			☐ Basement w/o plumbing	

Comments / Conditions: Pump, crush + fill existing tank. maintain maximum 6" of cover.

INITIAL SITE SKETCH

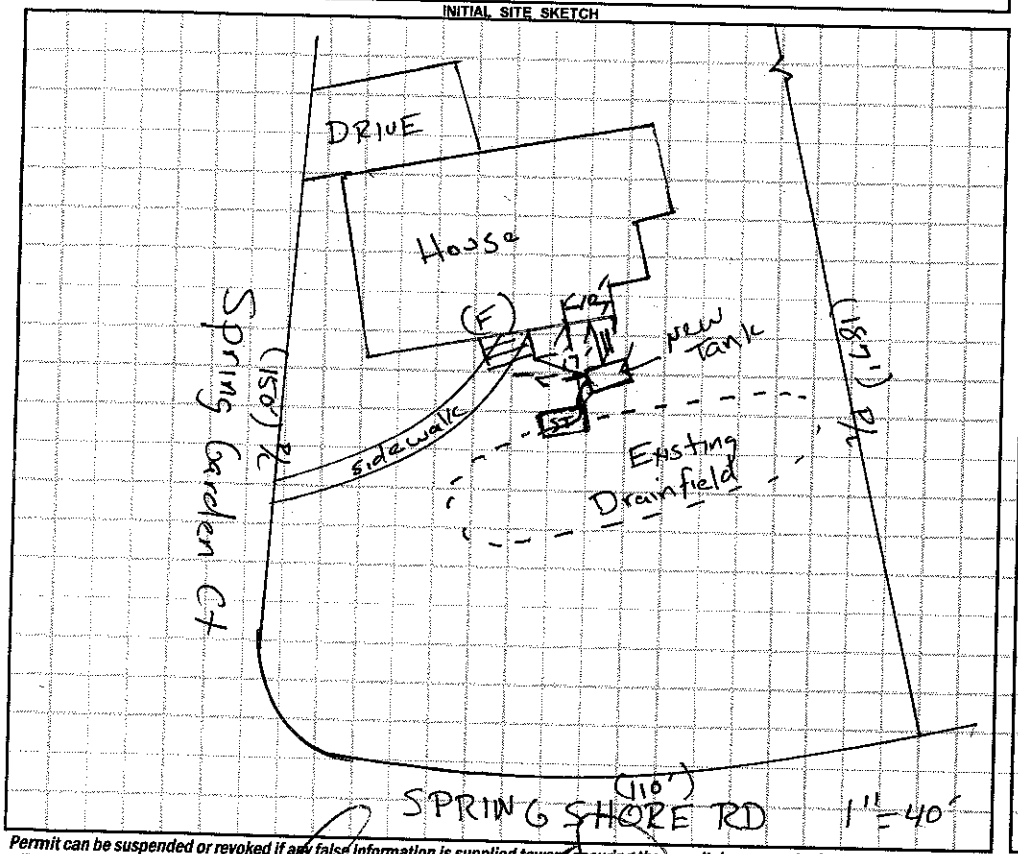

AS BUILT SKETCH

Installed Tank as drawn

*Pump, crush + fill existing tank, put tank in existing tanks spot x

Permit can be suspended or revoked if any false information is supplied toward securing the permit / any unauthorized changes are made to the site / any unauthorized changes are made in the installation of the system. CONTACT A LOCATOR SERVICE PRIOR TO ANY EXCAVATION

☐ IMPROVEMENT PERMIT *with plat* valid without expiration. ☒ IMPROVEMENT PERMIT *with site plan* valid for 60 mos. ☒ AUTHORIZATION TO CONSTRUCT valid for period equal to IMPROVEMENT PERMIT--not to exceed 60 mo.

Owner / Applicant Signature: Date: 4-1-14 Installed by: Steve Jordan

IMPROVEMENT PERMIT by: Date: 03/31/14 OPERATION PERMIT by: Date: 04/10/14

AUTHORIZATION TO CONSTRUCT by: Date: 03/31/14 Existing System Inspected by: Date:

Health Dept. Copy - WHITE Applicant (Final Approval) - YELLOW Applicant (Conditional Approval) - PINK