IREDELL COUNTY HEALTH DEPARTMENT

Statesville Phone TR 3-7271 Mooresville Phone No. 664-5281

PERMIT TO INSTALL SEPTIC TANK

Permit No. 211 Permit Date 2-28 1973

Owner Rick Dyson Bldr. Address Statesville N.C.

Installed By Robert Hoke Address Statesville NC.

Location of Property Spring Shores - Lot # 130


House on R.

Tank		Capacity		Length of Lines		Fixtures	
Block	( )	1000	( )	225'	( )	No. of Baths	(3)
Precast	(✓)	1250	(✓)	250'	( )	Dishwasher	(✓)
		1500	( )	Other 280'		Garbage Grdr.	(✓)
		Other				Other	

NOTIFY HEALTH DEPARTMENT AT LEAST EIGHT HOURS BEFORE TANK IS TO BE INSPECTED.

Final Inspection 2-28 1973 Approved (✓) Disapprcved ( )

Remarks Community Water

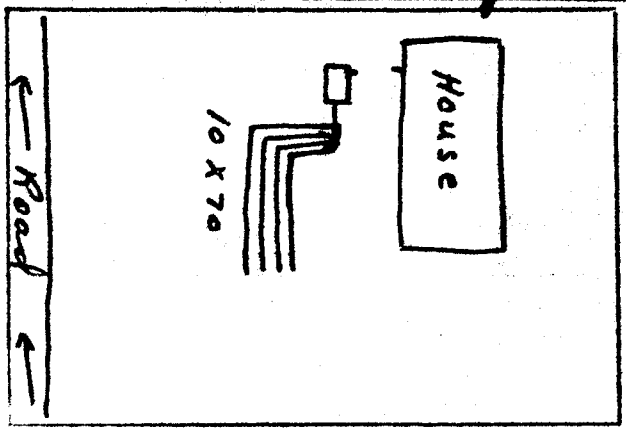

Sketch of Installation

E. A. Stevenson

Sanitarian