IREDELL COUNTY HEALTH DEPARTMENT

Statesville Office (704) 878-5305 Mooresville Office (704) 660-3625 PERMIT # 206747

IMPROVEMENT PERMIT / AUTHORIZATION TO CONSTRUCT / OPERATION PERMIT / EXISTING SYSTEM

PIN # 4710886018

APPLICANT: Heritage Bldrs Co APPLICANT ADDRESS: 839 Tabor Rd Olin NC

SITE ADDRESS: 123 Spring Shore Drive PHONE: (704) 902 4680 ALT. PHONE: (704) 902 4682 (Eric Dyer)

SITE DIRECTIONS: Go Front St TL on ~~Rte~~ Buffalo Shoal TL on Pineville TR on Spring Shore 5th lot on left

SUBDIVISION: Spring Shore SECTION: N/A LOT # 5 LOT AREA: .4 ac DESIGN FLOW: 360 L.T.A.R.: .25

Septic Tank 1000 (gal) STB 1012-1000 Date 9-9-14
Pump Tank (gal) PT Date
Pump Make Model Serial #
Nitrification Fields 1 # Lines 5 Linear Ft: 360
Trench Width 36 Max. Trench Bottom Depth 30" Gravel Depth N/A


☑ New System ☐ Repair ☐ Expansion System Type: I ☑ III IV V VI
System Description: 25% reduction gravity
Repair System Description: pre 1982 Judge) 1977 .1945
Maintenance Agreement Required: ☐ YES ☑ NO
☑ GRAVITY ☐ PRESSURE

☑ Residence ☐ Business ☐ Other ☐ Slab ☐ Basement w/plumbing
No. Bedrooms 3 No. Persons 6 No. Employees
☑ Crawl Space ☐ Basement w/o plumbing

Water Supply: ☐ Private ☐ Public ☑ Community

Comments / Conditions: Drain lines end 18' from left P/L. Keep drive way within 15' of left P/L and run all buried utilities to left side of drive way next to P/L. Original Plat record date is Feb-1, 1971, and 100% repair area not required by rule .1945. Max septic system can be as close as 5' from P/L feasible repair area will be in right back quarter of lot.

INITIAL SITE SKETCH

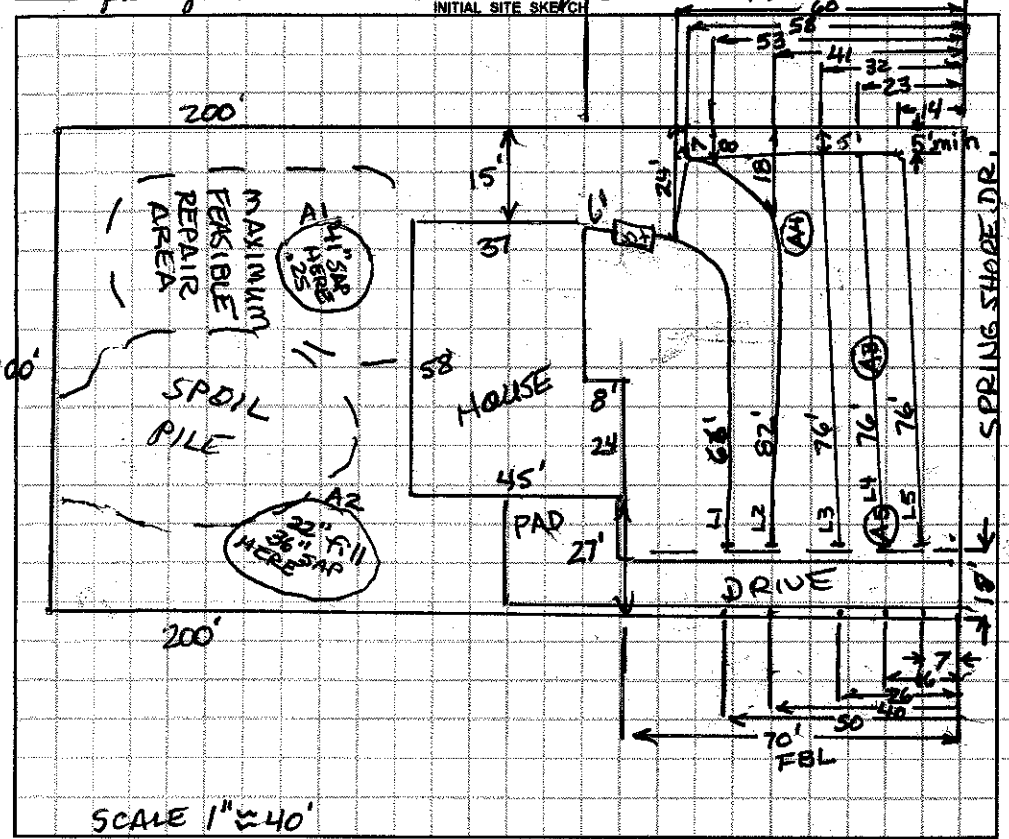

AS BUILT SKETCH

	Line Lengths flagged	design
L1	~~66~~ 66'	~~60~~ 64'
L2	~~82~~ 82	~~80~~ ~~80~~ 80'
L3	76'	72
L4	76'	72
L5	76'	72
	372'	360'

100'

- Yellow Tuff-Tite fittings installed
- Quick 4 Chambers installed
- 3" PVC ST marker installed.

Installed as drawn

Permit can be suspended or revoked if any false information is supplied toward securing the permit / any unauthorized changes are made to the site / any unauthorized changes are made in the installation of the system. CONTACT A LOCATOR SERVICE PRIOR TO ANY EXCAVATION

☐ IMPROVEMENT PERMIT *with plan* valid without expiration. ☑ IMPROVEMENT PERMIT *with site plan* valid for 60 mos. ☑ AUTHORIZATION TO CONSTRUCT valid for period equal to IMPROVEMENT PERMIT--not to exceed 60 mo.

Owner / Applicant Signature: Eric Dyer Date: 12-12-14 Installed by: Tommy Frye

IMPROVEMENT PERMIT by: Richard Morris Date: 12/5/14 OPERATION PERMIT by: Justin Henderson Date: 4-2-15

AUTHORIZATION TO CONSTRUCT by: Justin Henderson Date: 12-12-14 Existing System Inspected by: Date:

Health Dept. Copy - WHITE Applicant (Final Approval) - YELLOW Applicant (Conditional Approval) - PINK