IREDELL COUNTY HEALTH DEPARTMENT

Statesville Phone TR 3-7271 Mooresville Phone NO 3-1271

PERMIT TO INSTALL SEPTIC TANK

Permit No. 5 Permit Date 6-15 1971

Bldr.

Owner BENNY DANIEL Address STATESVILLE, N.C.

Installed By LACKEY BROS Address STONY POINT, N.C

Location of Property SPRING SHORE DEVELOPMENT


LOT # 4

Tank		Capacity		Length of Lines		Fixtures	
Block	( )	1000	(✓)	225'	(✓)	No. of Baths	(1½)
Precast	(✓)	1250	( )	250'	( )	Dishwasher	( )
		1500	( )	Other		Garbage Grdr.	( )
		Other				Other	

NOTIFY HEALTH DEPARTMENT AT LEAST EIGHT HOURS BEFORE TANK IS TO BE INSPECTED.

Final Inspection 6-15 1971 Approved (✓) Disapproved ( )

Remarks COMMUNITY WATER SUPPLY

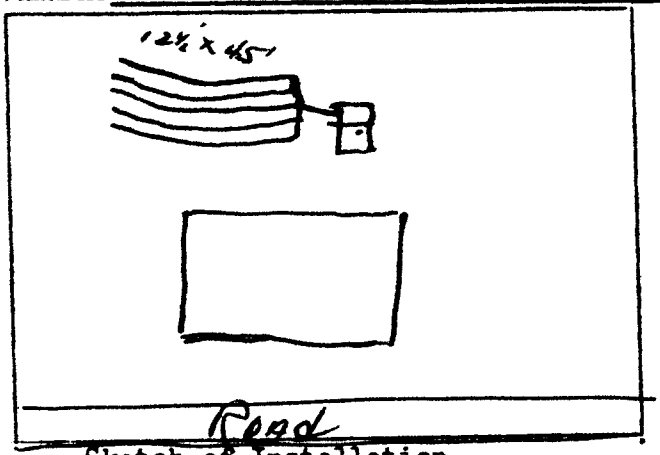

Sketch of Installation

Sanitarian