IREDELL COUNTY HEALTH DEPARTMENT

Statesville Phone TR 3-7271 Mooresville Phone NO 3-1271

PERMIT TO INSTALL SEPTIC TANK

Permit No. 6 Permit Date 6 - 15 1971

Owner Bldr. Ricky Dyson Address Taylorsville, N.C.

Installed By Lackey Bros. Address Stony Point, N.C.

Location of Property

Spring Shore Development


2nd House on Rt. Lot. 8

Tank		Capacity		Length of Lines		Fixtures	
Block	( )	1000	(✓)	225'	(✓)	No. of Baths	(1½)
Precast	(✓)	1250	( )	250'	( )	Dishwasher	( )
		1500	( )	Other		Garbage Grdr.	( )
		Other				Other	

NOTIFY HEALTH DEPARTMENT AT LEAST EIGHT HOURS BEFORE TANK IS TO BE INSPECTED.

Final Inspection 6 - 15 1971 Approved (✓) Disapproved ( )

Remarks

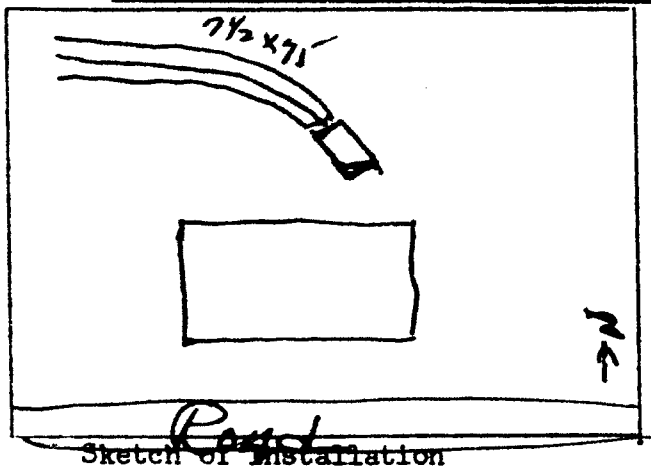

Sketch of Installation

Sanitarian