IREDELL COUNTY HEALTH DEPARTMENT

Statesville Phone TR 3-7271 Mooresville Phone No. 664-5281

PERMIT TO INSTALL SEPTIC TANK

Permit No. _____ Permit Date 8-21 19 73

Owner B.A. DANIELS & ASSOCIATES Address _____

Installed By Robt. Hake & R.E. Fay Address _____


Location of Property Spring Shores — 2nd House ON LEFT from ENTRANCE Lot # 3

Tank		Capacity		Length of Lines		Fixtures	
Block	( )	1000	( )	225'	( )	No. of Baths	(2)
Precast	(✓)	1250	(✓)	250'	( )	Dishwasher	(✓)
		1500	( )	Other 270		Garbage Grdr.	(✓)
		Other _____				Other _____	

NOTIFY HEALTH DEPARTMENT AT LEAST EIGHT HOURS BEFORE TANK IS TO BE INSPECTED.

Final Inspection 8-21 1973 Approved (✓) Disapproved ( )

Remarks Community Water

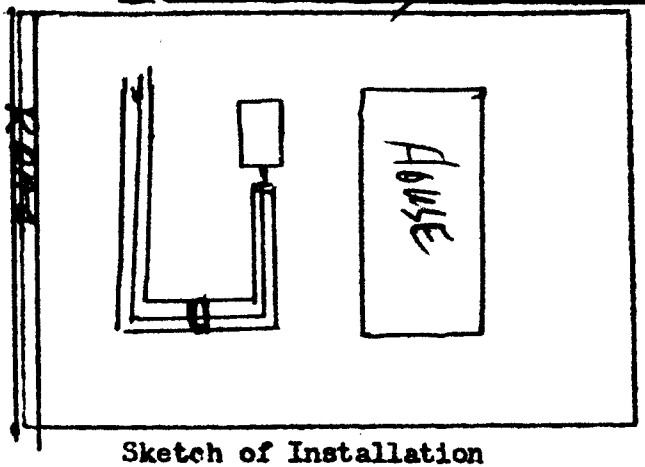

Sketch of Installation

Sanitarian