IREDELL COUNTY HEALTH DEPARTMENT

Statesville Office (704) 878-5305 Mooresville Office (704) 660-3625 PERMIT # 222166

IMPROVEMENT PERMIT / AUTHORIZATION TO CONSTRUCT / OPERATION PERMIT / EXISTING SYSTEM

PIN # 4710-88-9017

APPLICANT: William Parker APPLICANT ADDRESS: 109 Spring Shore Rd Statesville, NC 28677

SITE ADDRESS: 109 Spring Shore Rd. Statesville, NC 28677 PHONE: 704-528-6328 ALT. PHONE:

SITE DIRECTIONS: Buffalo Shoals Rd W from Statesville → L on Pineville Rd → R on Spring Shore Rd → House on left (first)

SUBDIVISION: Spring Shore SECTION: LOT # 2 LOT AREA: < 1.0 acre DESIGN FLOW: 3 L.T.A.R.: —

Septic Tank 1000 (replace) (gal) STB 760 Date 8-30-16
Pump Tank — (gal) PT — Date —
Pump Make — Model — Serial # —
Nitrification Fields Ex # Lines Ex Linear Ft: Ex
Trench Width Ex Max. Trench Bottom Depth Ex Gravel Depth Ex

☐ New System ☒ Repair ☐ Expansion System Type: I (II) III IV V VI
System Description: Replace collapsed septic tank.
Repair System Description: as needed. Pump + crush in place
Maintenance Agreement Required: ☐ YES ☒ NO
☒ GRAVITY ☐ PRESSURE


☒ Residence No. Bedrooms 3
☐ Business No. Persons 6
☐ Other No. Employees
☐ Slab ☒ Crawl Space
☐ Basement w/plumbing ☐ Basement w/o plumbing

Water Supply: ☐ Private ☐ Public ☒ Community


Comments / Conditions: Follow all N.C. septic rules. Existing tank is to be pumped, limed + crushed in place OR filled with essentially self-leveling fill (sand, gravel, concrete) Recommend pumping new septic tank every 3-5 years.

Recommend abandoning property line between lots 1+2 to attain compliance with respective setbacks.

INITIAL SITE SKETCH

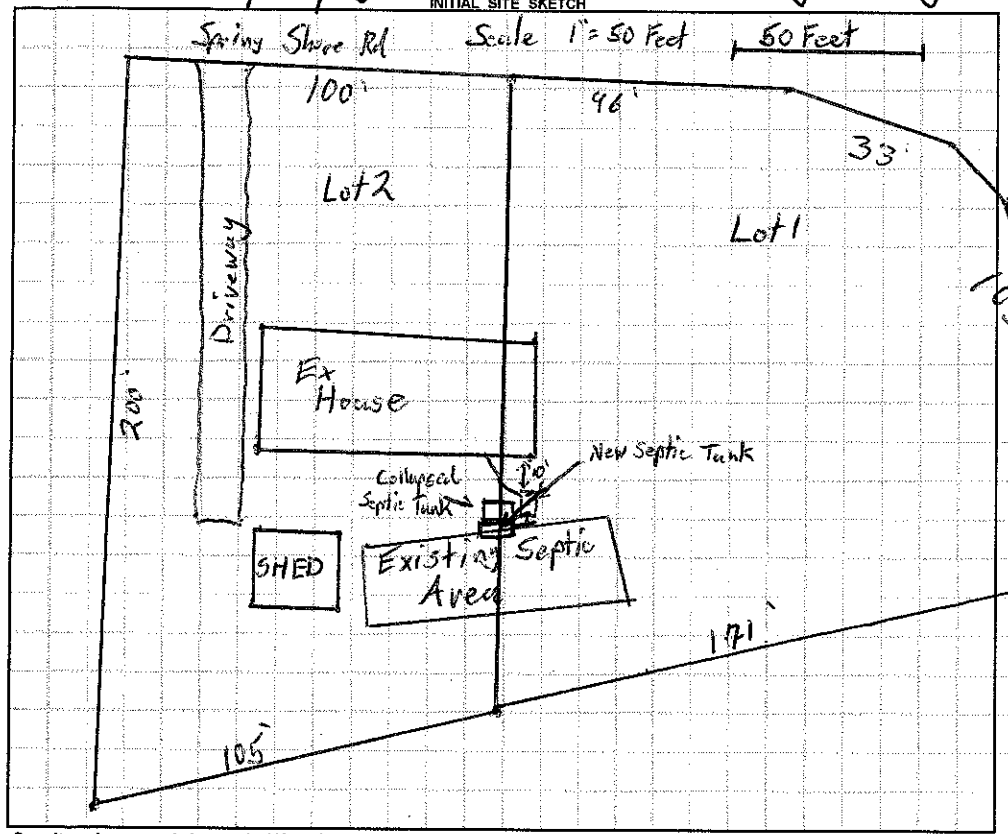

AS BUILT SKETCH

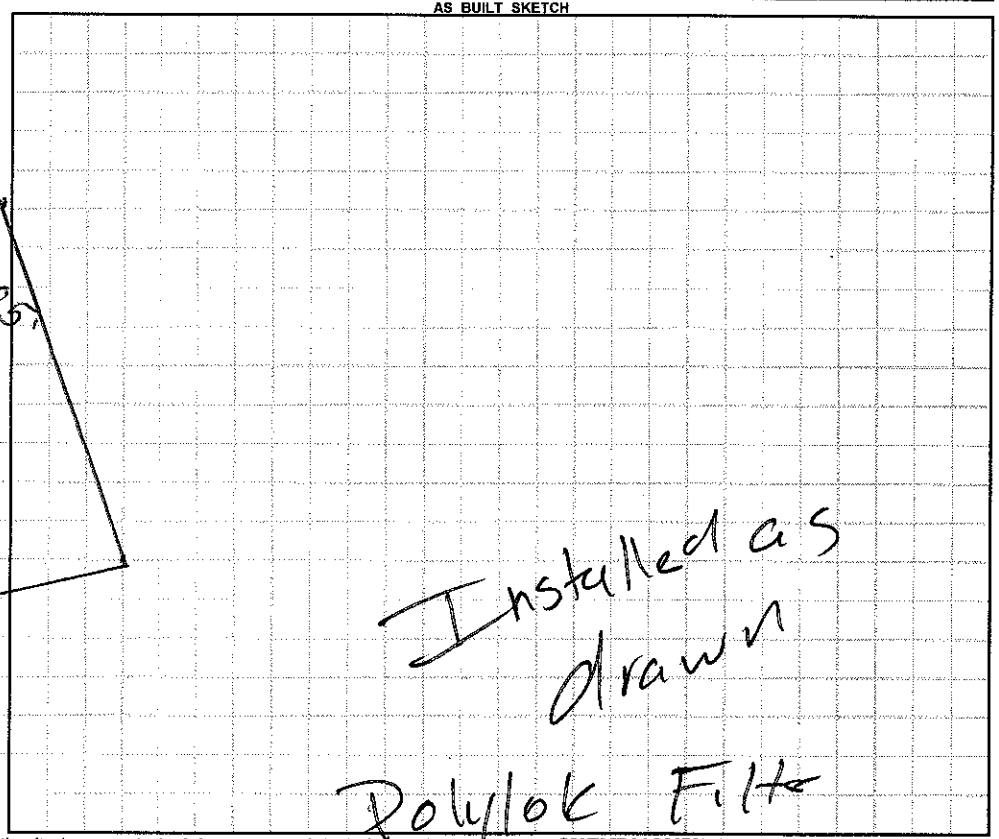

Permit can be suspended or revoked if any false information is supplied toward securing the permit / any unauthorized changes are made to the site / any unauthorized changes are made in the installation of the system. **CONTACT A LOCATOR SERVICE PRIOR TO ANY EXCAVATION**

☐ **IMPROVEMENT PERMIT** *with plat valid without expiration.* ☒ **IMPROVEMENT PERMIT** *with site plan valid for 60 mos.* ☒ **AUTHORIZATION TO CONSTRUCT** *valid for period equal to IMPROVEMENT PERMIT--not to exceed 60 mo.*

Owner / Applicant Signature: Jeanette Parker Date: Installed by: Lantz Wastewater

IMPROVEMENT PERMIT by: Tom Shuck Date: 10-3-2016 OPERATION PERMIT by: Date: 10/14/16

AUTHORIZATION TO CONSTRUCT by: Tom Shuck Date: 10-4-2016 Existing System Inspected by: Date:

Health Dept. Copy - WHITE Applicant (Final Approval) - YELLOW Applicant (Conditional Approval) - PINK