IREDELL COUNTY HEALTH DEPARTMENT

Statesville Phone TR 3-7271 Mooresville Phone NO 3-1271

PERMIT TO INSTALL SEPTIC TANK

Permit No. 2148 Permit Date 3-15 1972

Owner Ricky Ryan Address Troutman N.C.

Installed By Richard Blake Address Statesville N.C.

Location of Property


Lot #2 Spring Shore

Tank		Capacity		Length of Lines		Fixtures	
Block	( )	1000	( )	225'	( )	No. of Baths	( )
Precast	(✓)	1250	(✓)	250'	( )	Dishwasher	( )
		1500	( )	Other 255		Garbage Grdr.	( )
		Other				Other	

NOTIFY HEALTH DEPARTMENT AT LEAST EIGHT HOURS BEFORE TANK IS TO BE INSPECTED.

Final Inspection 3-15 1972 Approved (✓) Disapproved ( )

Remarks

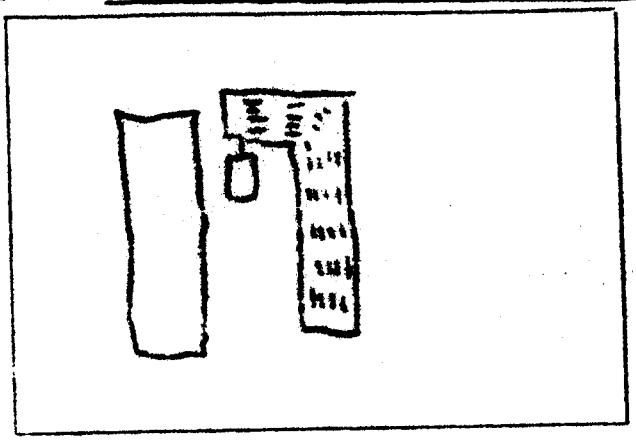

Sketch of Installation

R. L. Whitman R.S.

Sanitarian