IREDELL COUNTY HEALTH DEPARTMENT

STATESVILLE 704-878-5305 MOORESVILLE 704-664-5281

IMPROVEMENT PERMIT / AUTHORIZATION TO CONSTRUCT / OPERATION PERMIT / EXISTING SYSTEM INSPECTION

PERMIT# REPAIR PIN# 4710-88-9360

OWNER OR APPLICANT ROGER C. BURRELL PHONE: Business 704-437-2177 Home

ADDRESS 774 ANTIOCH ROAD, SPARTA NC 28675-8580 DATE 4-15-08

LOCATION BUFFALO SHOALS ROAD TO PINEVILLE ROAD TO SPRING SHORE, 1ST LOT ON RIGHT

SUBDIVISION SPRING SHORE BLOCK / SECTION LOT 136 LOT AREA 1 ACRE SITE CLASS PS DESIGN FLOW 360 L.T.A.R. EXISTING

Septic Tank: 1000 Gallons; STB 1012 Date 10-19-07

Pump Tank: Gallons; PT Date

Pump Make: Model Serial No.

Nitrification Field: No Fields 1 Square Feet EXISTING Linear Feet EXISTING

No Lines Trench Width Max Trench Bottom Depth Gravel Depth

☐ New System ☒ Repair ☐ Expansion System Type: I (II) III IV V VI

System Description:

Repair System Description: CONVENTIONAL, GRAVITY

Maintenance Agreement Required: ☐ Yes ☒ No

☒ Gravity ☐ Pressure

☒ House/Mod. Home No. Bedrooms 3

☐ Mobile Home No. Persons

☐ Business No. Employees

☐ Other


☐ Slab ☐ Crawl Space ☐ Basement w/plumbing ☐ Basement wo/plumbing

Water Supply: ☐ Individual ☒ Public ☐ Community


Comments:/Conditions: REPLACE EXISTING SEPTIC TANK WITH NEW TANK AT LOCATION SHOWN.

Comments:/Conditions: SEPTIC TANK WITH RISERS INSTALLED USING "ZABEL" FILTER

INITIAL SITE SKETCH

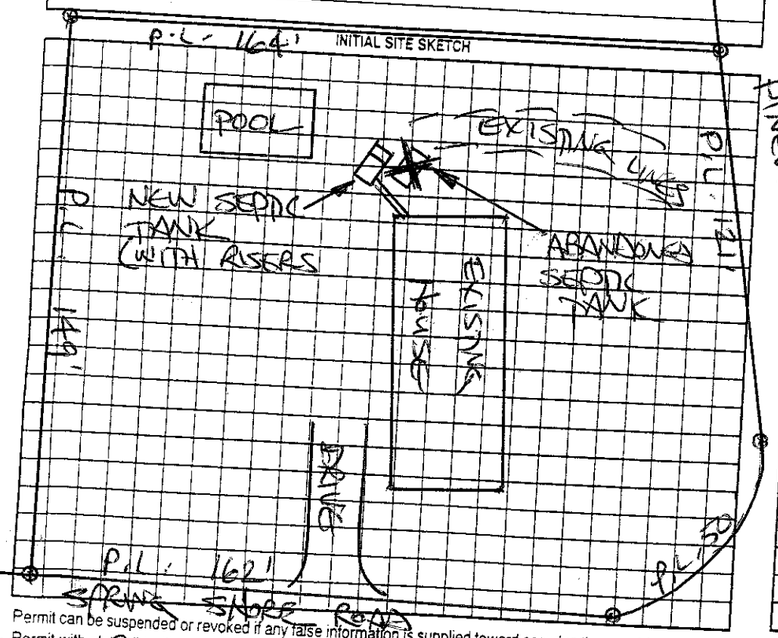

AS BUILT SKETCH

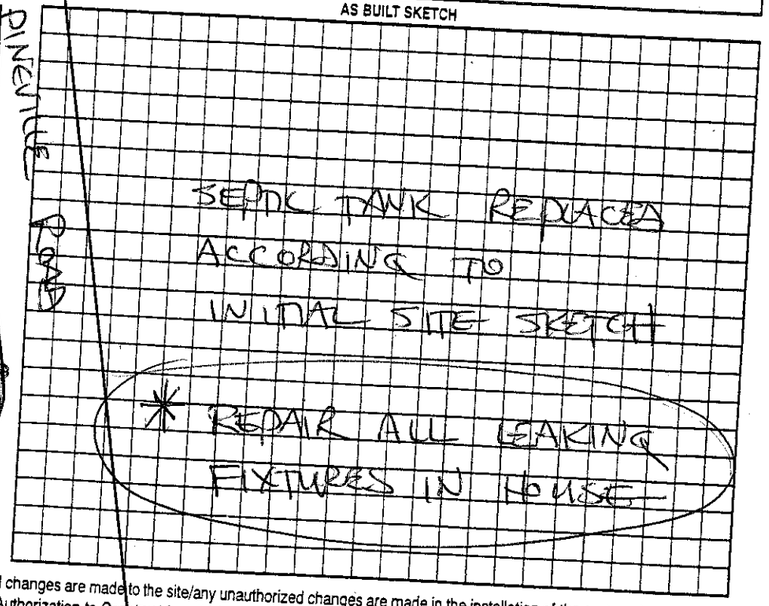

Permit can be suspended or revoked if any false information is supplied toward securing the permit/any unauthorized changes are made to the site/any unauthorized changes are made in the installation of the system. Improvement Authorization to Construct is valid for a period equal to that of Improvement Permit – not to exceed sixty months.

☐ Permit with plan valid without expiration ☒ Improvement Permit with site plan valid for sixty months

Signed Roger C Burrell date 4-15-08

Improvement Permit by: STEVE HENDRICK date 4-15-08

Authorization to Construct by: STEVE HENDRICK date 4-15-08

Installed by: JARED LENTZ

Operation Permit by: STEVE HENDRICK date 4-17-08

Existing System Inspection by: date

HEALTH DEPT. COPY: WHITE OWNER COPY (FINAL): YELLOW OWNER COPY (INITIAL): PINK