IREDELL COUNTY HEALTH DEPARTMENT

STATESVILLE 704-878-5305 MOORESVILLE 704-664-5281

IMPROVEMENT PERMIT / AUTHORIZATION TO CONSTRUCT / OPERATION PERMIT / EXISTING SYSTEM INSPECTION

PERMIT# 86420 PIN# 4710897397

OWNER OR CONTRACTOR Matthew Asbury / old Towne MH PHONE: Business (704) 873-1481 Home DATE Jan 28-2000

ADDRESS 582 Pineville

LOCATION Buffalo Shoals West (L) Pineville Rd (R) Sky Lane 1st mH on left

SUBDIVISION BLOCK / SECTION LOT LOT AREA 3/A SITE CLASS DESIGN FLOW L.T.A.R.

Septic Tank: 1000 EXISTING Gallons; STB Date

Pump Tank: Gallons; PT Date

Pump Make: Model Serial No.

Nitrification Field: No Fields Square Feet Linear Feet 100

No Lines 2 Trench Width 36" Max Trench Bottom Depth 36" Gravel Depth N/A

☑ New System ☐ Repair System Type: I, II, (III) IV, V, VI

System Description: 25% Reduction Syst.

Repair System Description: Pump

Maintenance Agreement Required: ☐ Yes ☐ No

☐ House/Mod. Home ☑ Mobile Home ☐ Business ☐ Other

No. Bedrooms 3 No. Bathrooms 2 No. Employees

☐ Slab ☐ Crawl Space ☐ Basement w/plumbing ☑ Basement wo/plumbing

Water Supply: ☑ Individual ☐ Public ☐ Community

WELL


Comments/Conditions: USE 10 HDS Sections

INSTALL on CONTOUR 2 Drop Boxes on Flow dividers Tee

Replace EXISTING DISTRIBUTION BOX

No BASEMENT CUT OVER 24" NEXT TO Nead septic Line

INITIAL SITE SKETCH

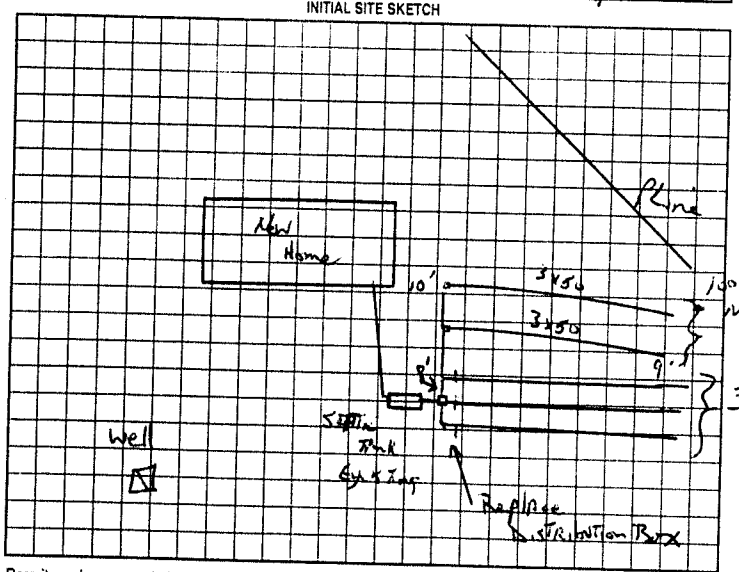


Comments/Conditions:

Home should be set TO INSURE GRADE FALL TO Septic Tank

Installed 16 InFiltrator Chambers

(Dist. Box was OK) AS BUILT SKETCH

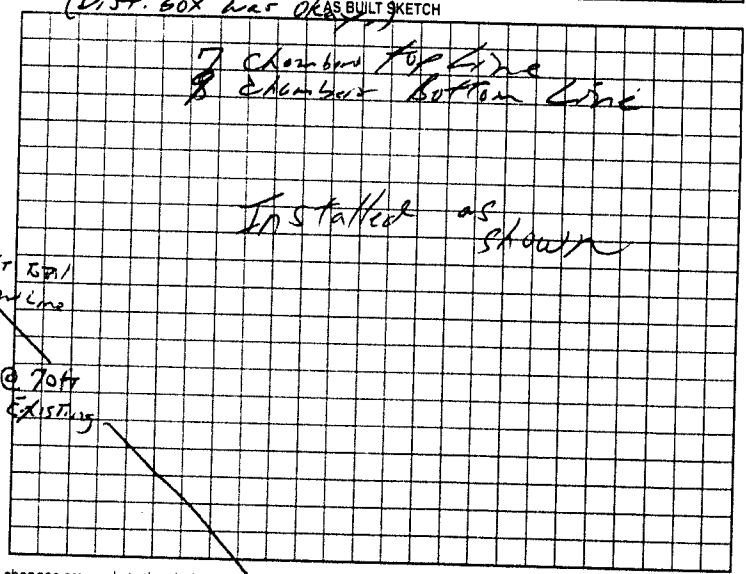

Permit can be suspended or revoked if any false information is supplied toward securing the permit/any unauthorized changes are made to the site/any unauthorized changes are made in the installation of the system. Improvement Permit with plat valid without expiration. Improvement Permit with site plan valid for sixty months. Authorization to Construct is valid for a period equal to that of Improvement Permit – not to exceed sixty months.

Signed: Matthew Asbury date 2-7-00 Installed by: Todd Bowley

Improvement Permit by: Lee Potter date Jan 28 2000 Operation Permit by: William E Johnson date 5/23/01

Authorization to Construct by: Lee Potter date Jan 28 2000 Existing System Inspection by: date

HEALTH DEPT COPY: WHITE OWNER COPY (FINAL): YELLOW OWNER COPY (INITIAL): PINK