IREDELL COUNTY HEALTH DEPARTMENT

STATESVILLE 704-878-5305 MOORESVILLE 704-664-5281

IMPROVEMENT PERMIT / AUTHORIZATION TO CONSTRUCT / OPERATION PERMIT / EXISTING SYSTEM INSPECTION

PERMIT# 79381 PIN# 4710895566 DATE 5-27-99

OWNER OR CONTRACTOR Marlene Baker PHONE; Business _____ Home 5395466

ADDRESS 123 Sky Ln Statesville N.C.

LOCATION Buffalo Shoals TL Pineville TR Sky at end

SUBDIVISION _____ BLOCK / SECTION _____ LOT _____ LOT AREA 4.42 acres SITE CLASS PS DESIGN FLOW 240 L.T.A.R. .3

Septic Tank: 1000 Gallons; STB 1012 Date 4-24-99

Pump Tank: _____ Gallons; PT _____ Date _____

Pump Make: _____ Model _____ Serial No. _____

Nitrification Field: No Fields 1 Square Feet 606 Linear Feet 202

No Lines 4 Trench Width 36" Max Trench Bottom Depth 36" Gravel Depth N/A

~~New System~~ Repair System Type: I. II. III. IV. V. VI

System Description: Gravity 25% Red

Repair System Description: pump to panels

Maintenance Agreement Required: Yes No

Slab Crawl Space Basement w/plumbing Basement wo/plumbing

~~House/Mod. Home~~ Mobile Home Business Other


No. Bedrooms 2 No. Bathrooms 2 No. Employees _____

Water Supply: ~~Individual~~ Public Community


Comments/Conditions: Replace Permit issued 2-25-99 300'

Comments/Conditions: 4" cross over pipes

INITIAL SITE SKETCH

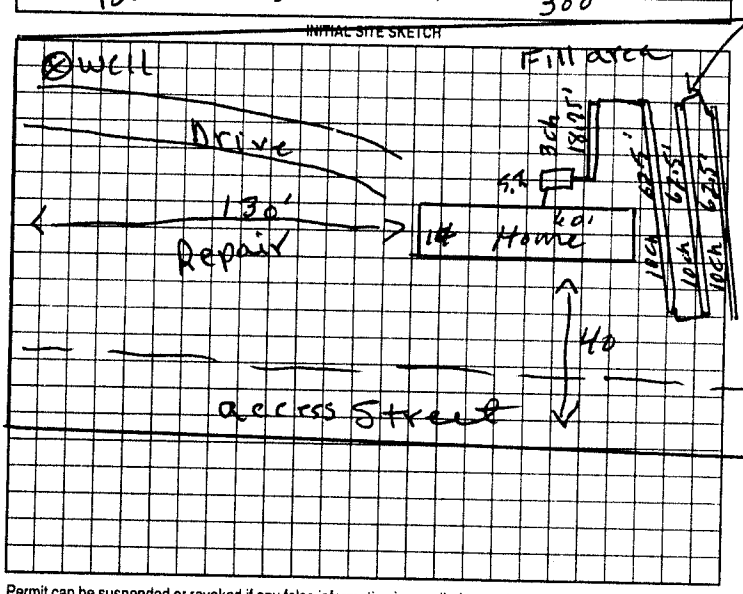

AS BUILT SKETCH

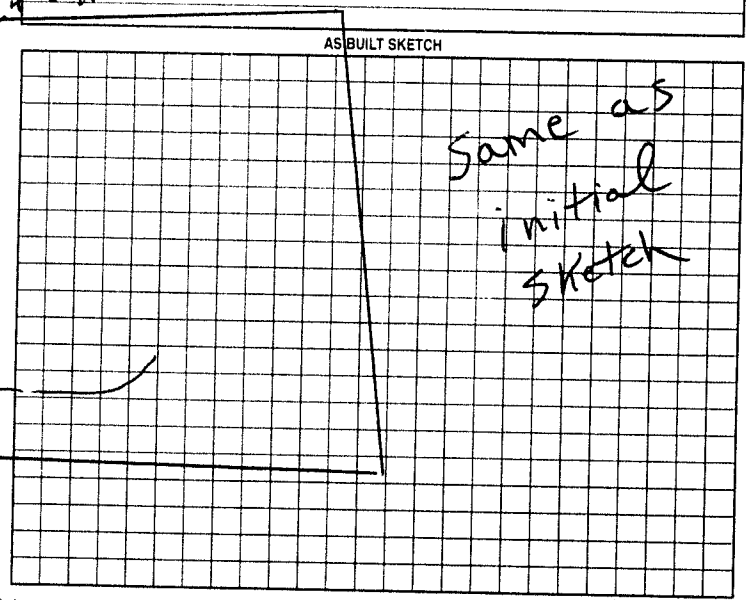

Permit can be suspended or revoked if any false information is supplied toward securing the permit/any unauthorized changes are made to the site/any unauthorized changes are made in the installation of the system. Improvement Permit with plat valid without expiration. Improvement Permit with site plan valid for sixty months. Authorization to Construct is valid for a period equal to that of Improvement Permit – not to exceed sixty months.

Signed: Marlene Baker date 5-27-99 Installed by: Tommy Frye

Improvement Permit by: P. C. Moore date 5-27-99 Operation Permit by: P. C. Moore date 6-14-99

Authorization to Construct by: P. C. Moore date 5-27-99 Existing System Inspection by: _____ date _____

HEALTH DEPT COPY WHITE OWNER COPY (FINAL) YELLOW OWNER COPY (INITIAL) PINK