IREDELL COUNTY HEALTH DEPARTMENT

Statesville Phone TR 3-7271 Mooresville Phone NO 3-1271

PERMIT TO INSTALL SEPTIC TANK

Permit No. _____ Permit Date April 28 1967

Owner Charles Williams Address _____

Installed By C Hoke Address R 7


Location of Property Lake Norman beyond Collier at E. Mombo - Clark S/D -

Tank		Capacity		Length of Lines		Fixtures	
Block	( )	1000	( )	225'	( )	No. of Baths	( )
Precast	( )	1250	( )	250'	( )	Dishwasher	( )
		1500	( )	Other 563 47'		Garbage Grdr.	( )
		Other _____				Other Cabin	

NOTIFY HEALTH DEPARTMENT AT LEAST EIGHT HOURS BEFORE TANK IS TO BE INSPECTED.

Final Inspection _____ 19___ Approved ( ) Disapproved ( )

Remarks Well not down this date.

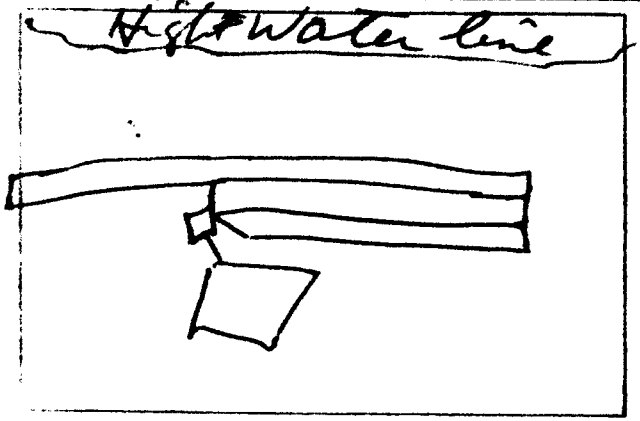

Sketch of Installation

Sanitarian