IREDELL COUNTY HEALTH DEPARTMENT

STATESVILLE 704-878-5305 CI MOORESVILLE 704-664-5281

IMPROVEMENT PERMIT / AUTHORIZATION TO CONSTRUCT / OPERATION PERMIT / EXISTING SYSTEM INSPECTION

PERMIT# 111692 PIN# 4710-91-0939 DATE 03-31-03

OWNER OR CONTRACTOR HORUE BLDG CO PHONE: Business 704-902-0399 Home 704-878-2224

ADDRESS 254 EAGLEWOOD DR STATESVILLE, NC 28625

LOCATION EAST MONRO; (C) WINMORE, (E) HERONWOOD 1½ mile on rt, drive bears off to right

SUBDIVISION HERONWOOD BLOCK / SECTION LOT 11 LOT AREA SITE CLASS. PS DESIGN FLOW 480 L.T.A.R. .3

Septic Tank: 1000 Gallons; STB 1012 Date 10-9-03
Pump Tank: Gallons; PT Date
Pump Make: Model Serial No.
Nitrification Field: No Fields 1 Square Feet 1600' Linear Feet 266'
No Lines 6x45' Trench Width 24" Max Trench Bottom Depth 36" Gravel Depth N/A

[X] New System [ ] Repair System Type: I, II, (III) IV, V, VI
System Description: GRN PANEL
Repair System Description: LP PANEL
Maintenance Agreement Required: [ ] Yes [X] No


[X] House/Mod. Home No. Bedrooms 4
[ ] Mobile Home No. Bathrooms 2
[ ] Business No. Employees
[ ] Other
[ ] Slab [ ] Crawl Space [X] Basement w/plumbing [ ] Basement wo/plumbing

Water Supply: [ ] Individual [X] Public [ ] Community

Comments/Conditions: (1) KEEP BASEMENT DAYLIGHT END AT NATURAL GRADE. DO NOT CUT (2) MAINTAIN SETBACKS, (3) INSTALL LINES ON CONTOURS (4) USE 1 FLOW DIVIDER TEE & 6 DROP BOXES AS DRAWN

Comments/Conditions: TUFF TITE FILTER + MARKER


INITIAL SITE SKETCH "NOT TO SCALE"

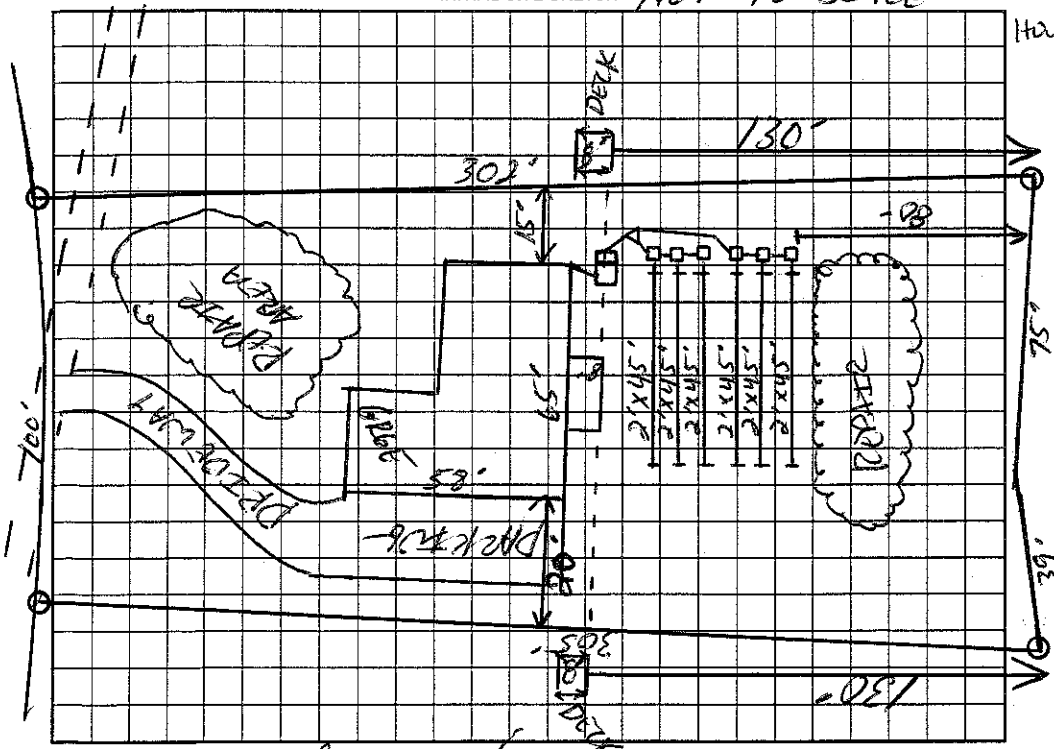

AS BUILT SKETCH

HOUSE CONTRACTOR APPROVED SEPTIC CHANGES DRAWN BELOW: 6 LINES 45' LONG / 1 FLOW DIVIDER TEE / 2 DIST BOX'S WITH SPEED LEVELERS. LAST BOX DIDN'T NEED SPEED LEVELERS. FED EQUAL.

"NOT TO SCALE"

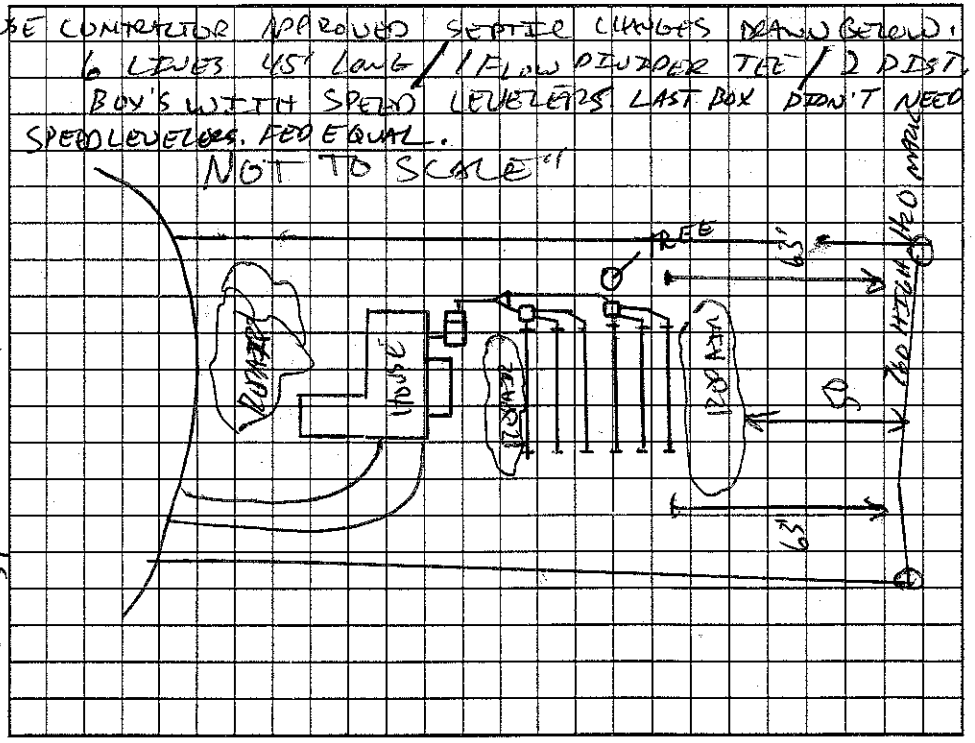

Permit can be suspended or revoked if any false information is supplied toward securing the permit/any unauthorized changes are made to the site/any unauthorized changes are made in the installation of the system. Improvement Permit with plat valid without expiration. Improvement Permit with site plan valid for sixty months. Authorization to Construct is valid for a period equal to that of Improvement Permit – not to exceed sixty months.

Signed: date Installed by: TOMMY TATE

Improvement Permit by: RS date 03-31-03 Operation Permit by: RS date 10-8-03

Authorization to Construct by: RS date 03-31-03 Existing System Inspection by: date

HEALTH DEPT. COPY: WHITE OWNER COPY (FINAL): YELLOW OWNER COPY (INITIAL): PINK