IREDELL COUNTY HEALTH DEPARTMENT

STATESVILLE 704-878-5305 MOORESVILLE 704-664-5281

IMPROVEMENT PERMIT / AUTHORIZATION TO CONSTRUCT / OPERATION PERMIT / EXISTING SYSTEM INSPECTION

PERMIT# 118683 PIN# 4710-91-4632 DATE 3-16-04

OWNER OR CONTRACTOR DIXIE RUTLEDGE DAVID WILLIS 704-309-4310 PHONE: Business 704-641-2592 Home 704-948-4066

ADDRESS 5935 SWANSTON DR CHARLOTTE NC 28269

LOCATION 21 SOUTH (E) PERTH (E) STATE PRK (E) ST JOHN (L) CLARK COVE LOT H 14 ON RT

SUBDIVISION OLD HOMESTEAD BLOCK / SECTION ____ LOT 14 LOT AREA .65AC SITE CLASS. PS DESIGN FLOW 360 L.T.A.R. .25

Septic Tank: 1000 Gallons: STB 317 Date 1-22-04
Pump Tank: 1000 Gallons: PT 283 Date 9-21-05
Pump Make: GOULDS Model WED 7 12 H Serial No. SC5404442
Nitrification Field: No Fields 1 Square Feet EDU=1440' Linear Feet 240'
No Lines 3 Trench Width 24" Max Trench Bottom Depth 36" Gravel Depth N/A


☒ New System ☐ Repair System Type: I, II, III, IV, V, VI
System Description: LP SD P/O REPAIR
Repair System Description: MAX FEES (1945)
Maintenance Agreement Required: ☒ Yes ☐ No

☒ House/Mod. Home No. Bedrooms 3
☐ Mobile Home No. Bathrooms 3.5
☐ Business No. Employees ____
☐ Other ____
☐ Slab ☐ Crawl Space ☒ Basement w/plumbing ☐ Basement wo/plumbing

Water Supply: ☒ Individual ☐ Public ☐ Community

Comments/Conditions: (1) OWNER OF LOT H 13 SAID THERE WAS NOT A PERMIT ON THAT LOT (2) DO NOT CUT FOR POSITIVE DRAINAGE SETBACKS. HOME MUST BE KEPT OUT OF GROUND & BACKFILLED FOR PERMIT 15' SETBACK

INITIAL SITE SKETCH ALLOWABLE

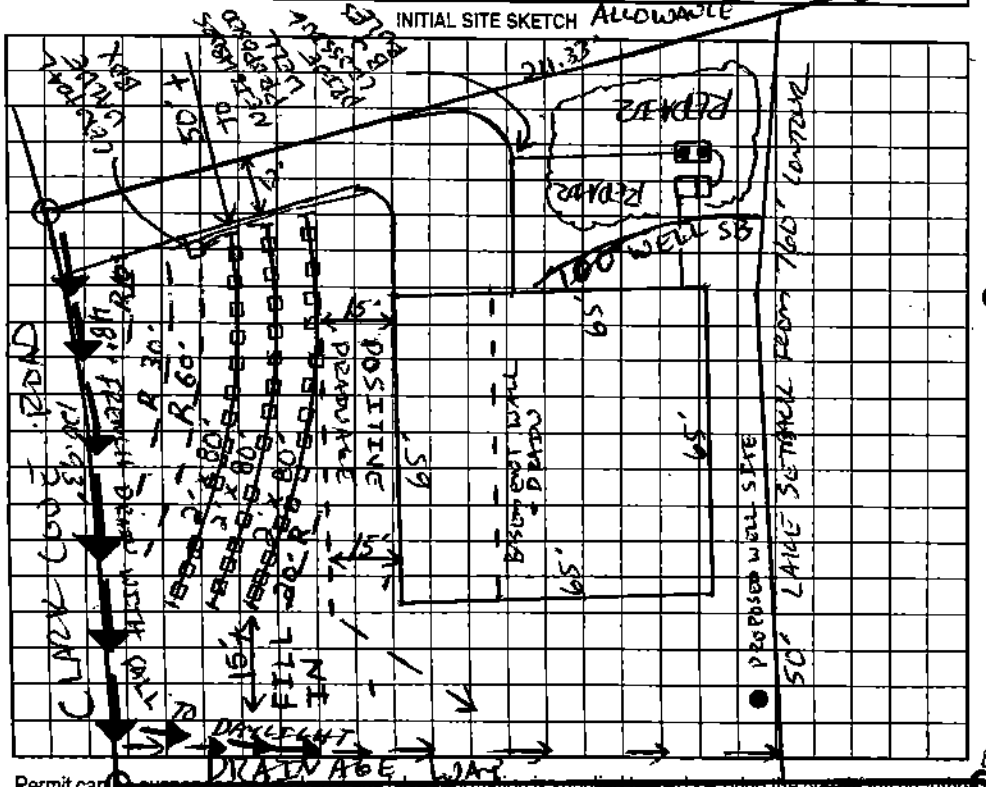

Comments/Conditions: (3) HOUSE & SYSTEM ARE COMPLETELY FLAGGED OUT (4) THIS SYSTEMS REQUIRES A CERTIFIED OPERATOR BY OP IS SIGNED (5) MAINTAIN SETBACKS & FOLLOW PROPER RULES FOR CROSSING UNDER THE DRIVEWAY (6) INSTALL 48" FRENCH AS BUILT SKETCH DRAIN WITH FALL TO DAYLIGHT

1"=40'

AS DEMO'D ON THE SUPERVISED P/L. (7) ALL PRIOR TO INSTALLATION FOR LOCATION OF PUMP SPECS IF NECESSARY. (8) LOT DOES NOT NEED REPAIR. DEEDED IN 1962. (9) UPSLOPE SIDE OF HOME MUST NOT HAVE A FOUNDATION DRAIN OR PERMIT WILL BE VOID.

POLY LOK Filter &
SIMTEC Filter Risers
W/D LINES W/ TANKS
W/ RETAINING

704-902-0892

Permit can be suspended or revoked if any false information is supplied toward securing the permit/any unauthorized changes are made to the site/any unauthorized changes are made in the installation of the system. Improvement Permit with plat valid without expiration. Improvement Permit with site plan valid for sixty months. Authorization to Construct is valid for a period equal to that of Improvement Permit – not to exceed sixty months.

Signed: Dixie Rutledge date 03/17/04

Improvement Permit by: [signature] date 3-16-04

Authorization to Construct by: [signature] date 3-16-04

Installed by: CUSTOM WIDE

Operation Permit by: [signature] date 7-27-06

Existing System Inspection by: ____ date ____

HEALTH DEPT. COPY: WHITE OWNER COPY (FINAL): YELLOW OWNER COPY (INITIAL): PINK