IREDELL COUNTY HEALTH DEPARTMENT

STATESVILLE 704-878-5305 MOORESVILLE 704-664-5281

IMPROVEMENT PERMIT / AUTHORIZATION TO CONSTRUCT / OPERATION PERMIT / EXISTING SYSTEM INSPECTION

PERMIT # Repair PIN # 4710922153 DATE 2/17/09

OWNER or APPLICANT Jim Diers PHONE: Business 704 682 6550 Home: 704 528 7968

OWNER or APPLICANT ADDRESS 254 Heronwood Rd

LOCATION / DIRECTIONS

SUBDIVISION n/a BLOCK / SECTION n/a LOT # ~~n/a~~ 8 LOT AREA n/a DESIGN FLOW n/a (360) L.T.A.R. ex

Septic Tank 1000 Gallons: STB 760 Date 1-12-89
Pump Tank ex Gallons: P T Date
Pump Make ex Model Serial #
Nitrification Field No Fields ex No Lines ex Linear Feet
Trench Width ex Max. Trench Bottom Depth ex Gravel Depth ex

☐ New System ☑ Repair ☐ Expansion System Type I (II) III IV V VI
System Description: Tank Replacement
Repair System Description:
Maintenance Agreement Required ☐ YES ☑ NO
☐ GRAVITY ☑ PRESSURE

☑ Residence No. Bedrooms 3
☐ Business No. Persons
☐ Other No. Employees
☐ Slab ☐ Crawl Space
☑ Basement w/plumbing ☐ Basement w/o plumbing


Water Supply
☐ Private
☑ Public
☐ Community

Comments / Conditions


1" = 50'

Comments / Conditions

INITIAL SITE SKETCH

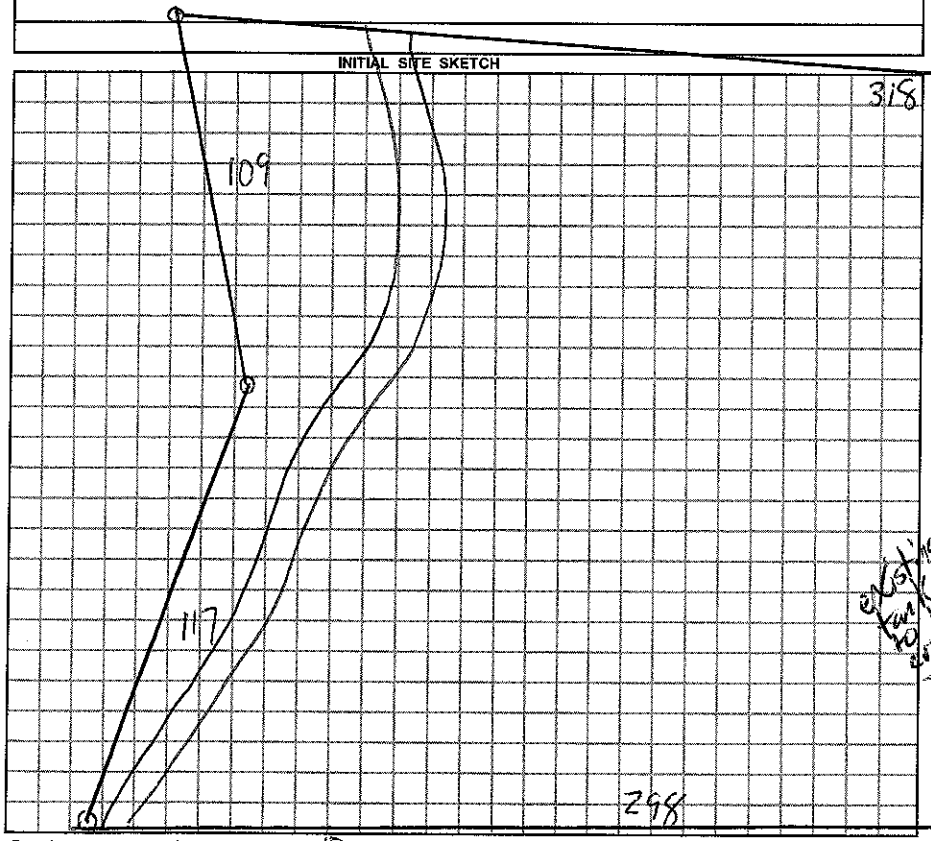

AS BUILT SKETCH

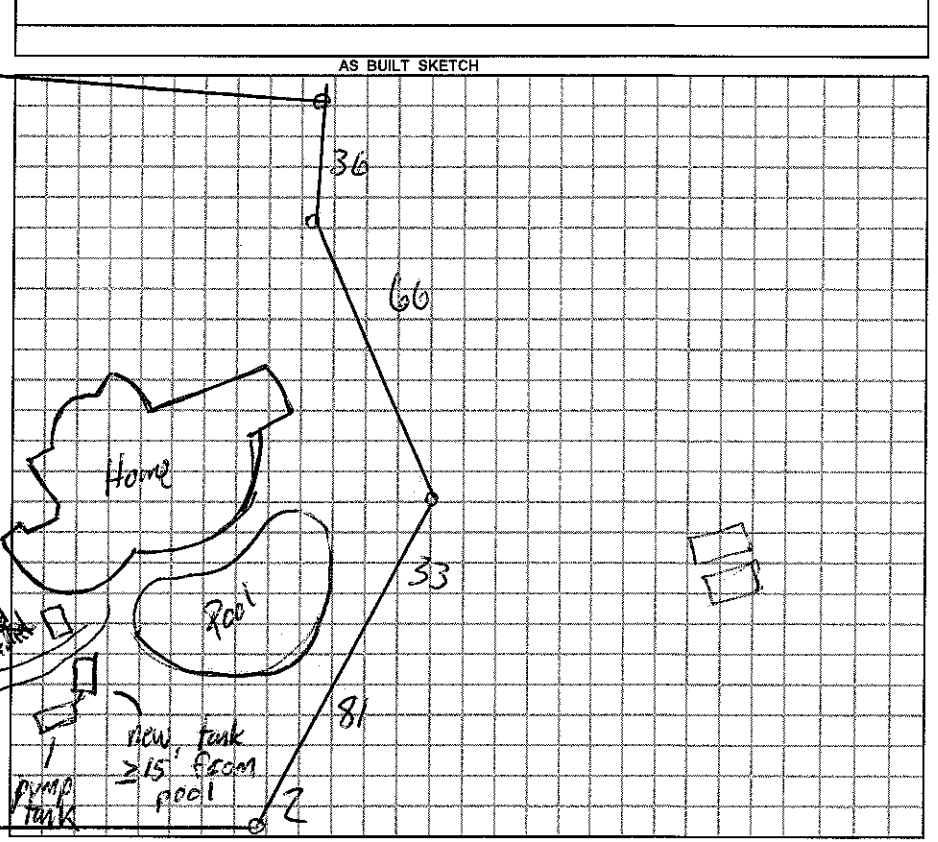

Permit can be suspended or revoked if any false information is supplied toward securing the permit / any unauthorized changes are made to the site / any unauthorized changes are made in the installation of the system.

☐ *IMPROVEMENT PERMIT w / plat valid without expiration.* ☐ *IMPROVEMENT PERMIT w / site plan valid for 60 mos.* ☐ *AUTHORIZATION TO CONSTRUCT valid for period equal to IMPROVEMENT PERMIT-not to exceed 60 mo.*

Owner / Applicant Signature: Jim Diers Date 2.17.09

Improvement Permit by: Date

Authorization to Construct by: Date 2/17/09

YOU SHOULD CONTACT A LOCATOR SERVICE PRIOR TO ANY EXCAVATION.

Installed by: Jared Lentz

Operation Permit by: Date: 2/24/09

Existing System Inspected by: Date:

WHITE COPY Environmental Health YELLOW COPY (Final) Owner / Applicant PINK COPY (Initial) Owner / Applicant