IREDELL COUNTY HEALTH DEPARTMENT

STATESVILLE 704-878-5305 MOORESVILLE 704-664-5281

IMPROVEMENT PERMIT / CERTIFICATE OF COMPLETION / OPERATION PERMIT / EXISTING SYSTEM INSPECTION

PROPERTY DESCRIPTION NO. 18062 DATE 4-5-94 TAX MAP NO. 3D-3-A-4 Watershed: ☐ Yes ☑ No

OWNER OR CONTRACTOR Joni Corson PHONE: Business Home 873-4377

ADDRESS 203 Valley St. Statesville, N.C. 28677

LOCATION From Troutmen take old Mtn Rd TL East Monbo Rd TL Windermere Rd TL Heronwood Rd. Lot near end on R.

SUBDIVISION Heronwood BLOCK / SECTION I LOT 4 LOT AREA 41,749 sq.ft. SITE CLASS. P.S. DESIGN FLOW 360 L.T.A.R. .5 gpd/ft2

Septic Tank: 1000 Gallons: STB 1012 Date 6-7-97
Pump Tank: — Gallons: PT — Date —
Pump Make: — Model — Serial No —
Nitrification Field: No Fields 1 Square Feet 1200 Linear Feet 400'
No Lines 5 Trench Width 36" Max Trench Bottom Depth 32" Gravel Depth 12"

☑ New System ☐ Repair System Type: I, II, III, IV, V, VI
System Description: Conventional, gravity fed
Repair System Description: pump to conventional
Maintenance Agreement Required: ☐ Yes ☑ No


☑ House/Mod. Home No. Bedrooms 3
☐ Mobile Home No. Bathrooms 3
☐ Business No. Employees
☐ Other
☐ Slab ☐ Crawl Space ☑ Basement w/plumbing ☐ Basement wo/plumbing

Water Supply: ☐ Individual ☑ Community ☐ Public


Comments: INSTALL SYSTEM SHALLOW (no deeper than 32" deep on upper side of trench.) Keep Nitrification Lines and Trenches on contour. Keep system 5' from any building foundation, 10' from all property lines, and 10' from water line. Keep system 50' from 760' elevation mark. Lot steep.

Comments:
* Tank moved
Garage moved to opposite side

INITIAL SITE SKETCH ≈ 35% slope, 100% Repair Area above home, pump to conventional.

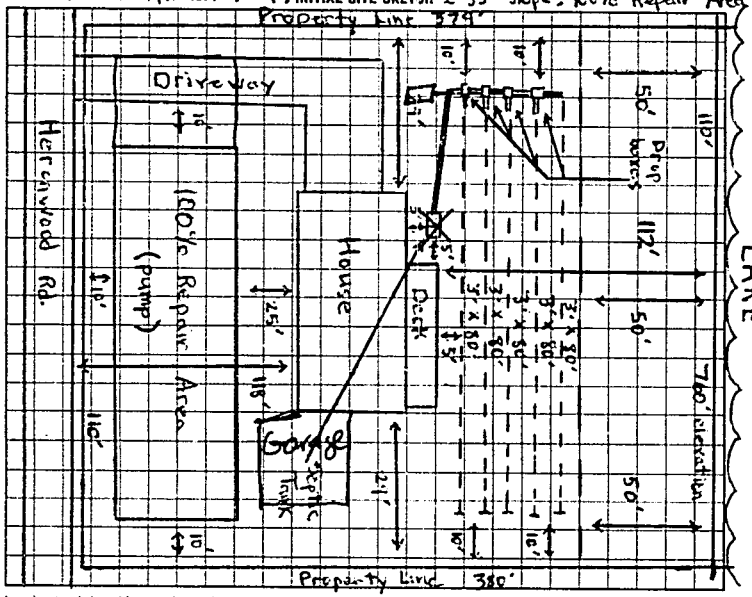

AS BUILT SKETCH

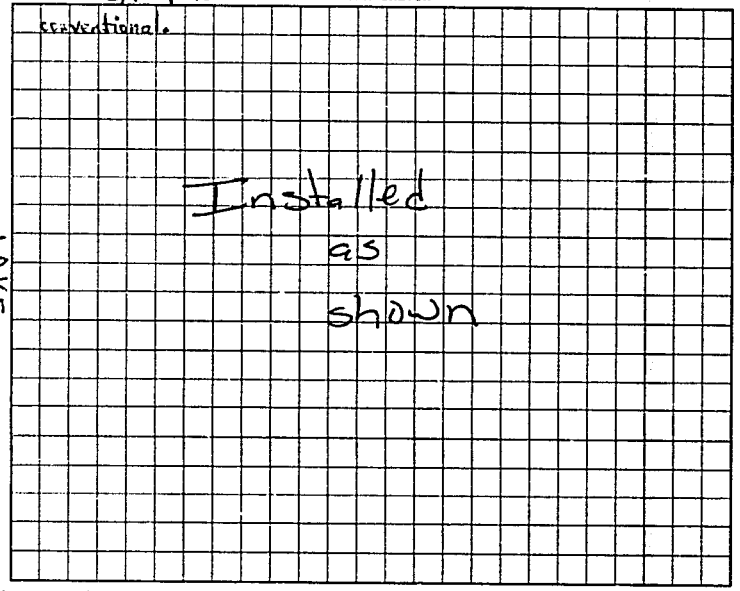

I understand that this permit can be suspended or revoked if any false information is supplied toward securing the permit/any unauthorized changes are made to the site/any unauthorized changes are made in the installation of the system. Improvement Permit is valid for 60 months from date of issuance.)

Signed: William Corson Jr.

Improvement Permit by: Michael L. Nichols date 4-5-94

Existing System Inspection by: date

Installed by: A-1 Backhoe

Certificate of Completion by: date

Operation Permit by: Mat C Ortes date 5-19-97

HEALTH DEPT. COPY: WHITE INSPECTION COPY (FINAL): GREEN OWNER COPY (FINAL): YELLOW INSPECTION COPY (INITIAL): PINK OWNER COPY (INITIAL): GOLD

990000