IREDELL COUNTY HEALTH DEPARTMENT

Statesville Phone TR 3-7271 Mooresville Phone No. 664-5281

PERMIT TO INSTALL SEPTIC TANK

Permit No. _____ Permit Date 4 - 24 1973

Owner Frank Davidson Address Statesville NC

Installed By Robert Hoke Address Statesville N.C.


Location of Property Go out E. Monbo Rd. T.L. at Bethel Baptist Church. T.L. at fork of road. T.R. at next fork in Road. House at end of Rd.

Tank		Capacity		Length of Lines		Fixtures	
Block	( )	1000	( )	225'	( )	No. of Baths	(3)
Precast	(✓)	1250	(✓)	250'	( )	Dishwasher	(✓)
		1500	( )	Other 270		Garbage Grdr.	(✓)
		Other _____				Other _____	

NOTIFY HEALTH DEPARTMENT AT LEAST EIGHT HOURS BEFORE TANK IS TO BE INSPECTED.

Final Inspection 4 - 24 1973 Approved (✓) Disapproved ( )

Remarks Well at top of hill beside road.

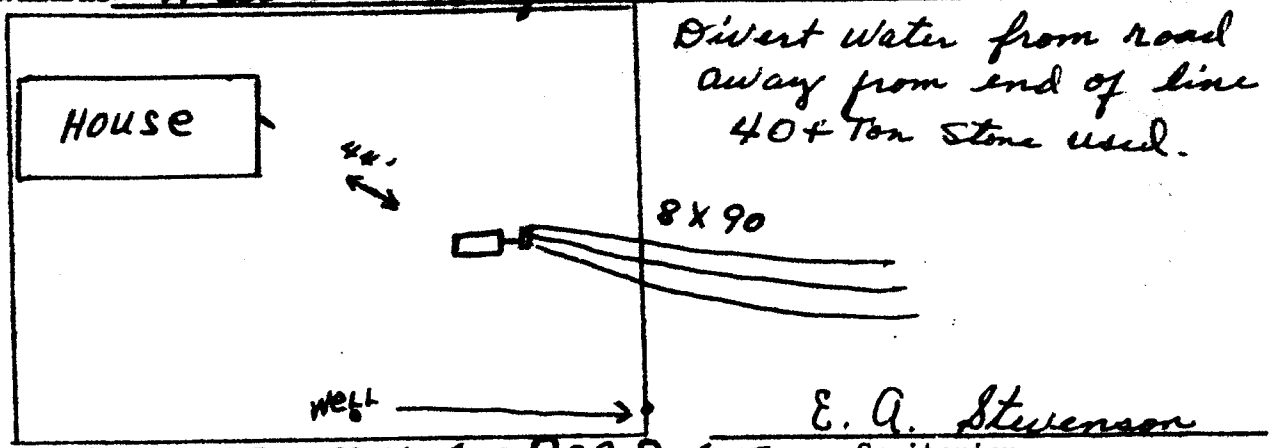

Divert water from road away from end of line 40+ Ton Stone used.

Sketch of Installation

E. A. Stevenson
Sanitarian