IREDELL COUNTY HEALTH DEPARTMENT

1:00

054880

STATESVILLE 704-878-5305 MOORESVILLE 704-664-5281

IMPROVEMENT PERMIT / CERTIFICATE OF COMPLETION / OPERATION PERMIT / EXISTING SYSTEM INSPECTION

PROPERTY DESCRIPTION NO 23140 DATE 2-26-96 TAX MAP NO 3L-B-23

OWNER OR CONTRACTOR JENELL R. BURUM PHONE: Business Home 664-1303 Watershed: Yes No

ADDRESS 184 BILLY JOE ROAD, MOORESVILLE, NC 28115

LOCATION BUFFALO SHOALS RD, TL PINEVILLE ROAD, ON RIGHT AT BOX #550 (B-4 SPRING SHOALS)

SUBDIVISION BLOCK / SECTION LOT LOT AREA 4.82 ± SITE CLASS PS DESIGN FLOW 240 L.T.A.R. 0.30 GPD/FT²

Septic Tank: 1000 Gallons; STB 1794 Date 2-20-96

Pump Tank: Gallons; PT Date

Pump Make: Model Serial No.

Nitrification Field: No Fields 1 Square Feet 810 Linear Feet 270

No Lines 3 Trench Width 36" Max Trench Bottom Depth 18-30"

✓ New System Repair System Type: I II III IV V VI

System Description: CONVENTIONAL GRAVITY

Repair System Description: CONV. GRAVITY

Maintenance Agreement Required Yes No

Gravel Depth 12 Slab ✓ Crawl Space Basement w/plumbing Basement wo/plumbing

House/Mod. Home No. Bedrooms 2

✓ Mobile Home No. Bathrooms 2

Business No. Employees

Other

✓ Water Supply

✓ Individual

Community


Public

WELL

Comments: ① KEEP SYSTEM MINIMUM 100' FROM WELL ② USE TWO DROP BOXES FOR SERIAL DISTRIBUTION INTO THREE LINES

Comments: 312' Drain line ~~270~~ installed instead of 270'

INITIAL SITE SKETCH

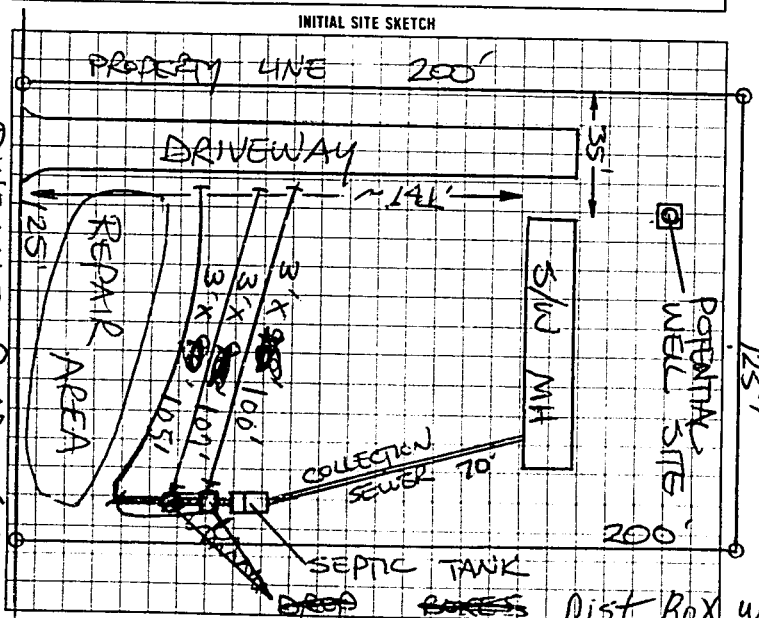

AS BUILT SKETCH

Well has not been installed at Time of this inspection

Keep 100' away from sewage System

I understand that this permit can be suspended or revoked if any false information is supplied toward securing the permit/any unauthorized changes are made to the site/any unauthorized changes are made in the installation of the system

AUTHORIZATION TO CONSTRUCT IS VALID FIVE (5) YEARS FROM DATE OF ISSUANCE. IMPROVEMENT PERMIT HAS NO EXPIRATION DATE.

Signed

Improvement Permit by: STEVE HENDRICK date 2-26-96 Installed by F. J. ERVIN

Existing System Inspected by date

Authorization to Construct: STEVE HENDRICK date 2-26-96 Certificate of Completion by date

Operation Permit by J. C. Moore date 3-29-96

HEALTH DEPT COPY WHITE INSPECTION COPY (INITIAL) GREEN OWNER COPY (INITIAL) YELLOW INSPECTION COPY (INITIAL) PINK OWNER COPY (INITIAL) GOLD

S 7 7 2 0 0