IREDELL COUNTY HEALTH DEPARTMENT

STATESVILLE 704-878-5305 MOORESVILLE 704-664-5281

IMPROVEMENT PERMIT / AUTHORIZATION TO CONSTRUCT / OPERATION PERMIT / EXISTING SYSTEM INSPECTION

PERMIT# 80851 PIN# 4711 03 2465 DATE 4-30 99

OWNER OR CONTRACTOR MARK Alley PHONE: Business _____ Home 528 4547

ADDRESS Box 152 Wildwood TRAIL

LOCATION Buffalo Shoals West PAST GRAY Rock on Right Drive on Left Wildwood TRAILER Follow Till 2nd home on Right

SUBDIVISION _____ BLOCK / SECTION _____ LOT _____ LOT AREA _____ SITE CLASS. P5 DESIGN FLOW 360 L.T.A.R. .4

Septic Tank: EXISTING Gallons; STB _____ Date _____

Pump Tank: _____ Gallons; PT _____ Date _____

Pump Make: _____ Model _____ Serial No. _____

Nitrification Field: No Fields ___ Square Feet _____ Linear Feet _____

No Lines _____ Trench Width 36" Max Trench Bottom Depth _____

[X] New System [ ] Repair System Type: I. II. III. IV. V. VI

System Description: _____

Repair System Description: 50% Reduction

Maintenance Agreement Required: [ ] Yes [ ] No

Gravel Depth 15" + [ ] Slab [ ] Crawl Space [ ] Basement w/plumbing [ ] Basement wo/plumbing

[ ] House/Mod. Home No. Bedrooms 3

[ ] Mobile Home No. Bathrooms 1½

[ ] Business No. Employees ___

[ ] Other _____

Water Supply: [ ] Individual [ ] Public [ ] Community WELL

Comments/Conditions: ① Remove Sprinkler Line & back Fill

② Locate end of 2nd Line and add 40-50 ft curve in bed to get Length if needed Keep Fall To ¼ inch


③ Locate end of 3rd Line And Add 20-30 ft Keeping 50 ft From Lake edge

④ Use EXTRA Stone in deepest end of Trench.


⑤ Landscape To Maintain drainage

Comments/Conditions: PER OWNER Request

INITIAL SITE SKETCH

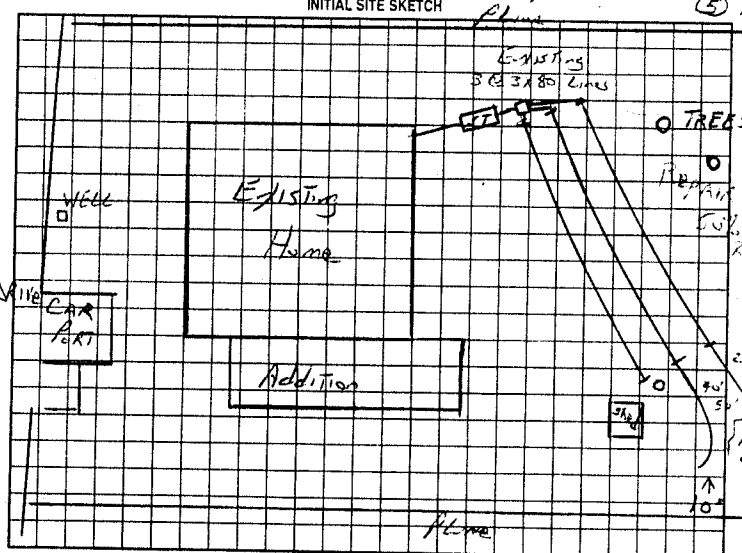

AS BUILT SKETCH ⑥ DIVERT GUTTER drains from System

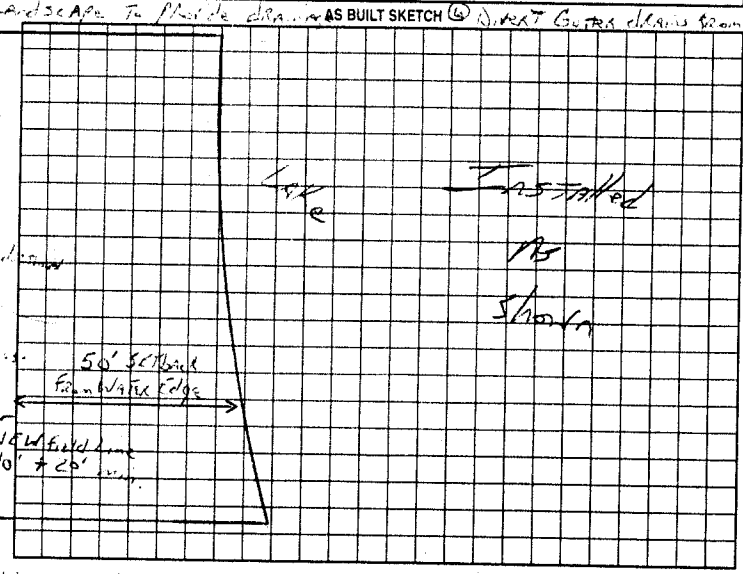

Permit can be suspended or revoked if any false information is supplied toward securing the permit/any unauthorized changes are made to the site/any unauthorized changes are made in the installation of the system. Improvement Permit with plat valid without expiration. Improvement Permit with site plan valid for sixty months. Authorization to Construct is valid for a period equal to that of Improvement Permit – not to exceed sixty months.

Signed: Mark Alley date 5/14/99

Improvement Permit by: J.C. Potter date 4-30-99

Authorization to Construct by: J.C. Potter date 4-30-99

Installed by: Wayne Clontz

Operation Permit by: J.C. Potter date Jan 3 2000

Existing System Inspection by: _____ date _____

HEALTH DEPT. COPY: WHITE OWNER COPY (FINAL): YELLOW OWNER COPY (INITIAL): PINK