72x 67 #130

IREDELL COUNTY HEALTH DEPARTMENT

STATESVILLE 704-878-5305 (C1) MOORESVILLE 704-664-5281

IMPROVEMENT PERMIT / AUTHORIZATION TO CONSTRUCT / OPERATION PERMIT / EXISTING SYSTEM INSPECTION

PERMIT# 109829 PIN# ~~4711085267.2~~ 4711-04-4705 DATE 3/27/03

OWNER OR CONTRACTOR BRIDGEWATER CO. LLC PHONE: Business 799-9770 Home

ADDRESS PO BOX 3608 MOORESVILLE NC 28117

LOCATION BUFFALO SHOALS TOWARD LAKE - TL WINDING WOOD - 2nd ON LT

SUBDIVISION RIDGEWOOD BLOCK / SECTION LOT 2 LOT AREA 2.25AC SITE CLASS. PS DESIGN FLOW 480GPD L.T.A.R. .36-PD/FT2

Septic Tank: 1000 Gallons; STB 1007 Date 9-26-05
Pump Tank: Gallons; PT Date
Pump Make: Model Serial No.
Nitrification Field: No Fields 1 Square Feet 1200 Linear Feet 400
No Lines 4@100' Trench Width 36" Max Trench Bottom Depth 36" Gravel Depth N/A

☒ New System ☐ Repair System Type: I, II, (III) IV, V, VI
System Description: GRAVITY 25% REDUCTION
Repair System Description: LP PANEL
Maintenance Agreement Required: ☐ Yes ☒ No


☒ House/Mod. Home No. Bedrooms 4
☐ Mobile Home No. Bathrooms 4
☐ Business No. Employees
☐ Other
☐ Slab ☐ Crawl Space ☒ Basement w/plumbing ☐ Basement wo/plumbing

Water Supply: ☒ Individual ☐ Public ☐ Community


Comments/Conditions:

Comments/Conditions: Approved 72'x67' FLOOR PLAN. SYSTEM DOES NOT AFFECT SYSTEM AREA, DOING CRAWLSPACE, NOT A BASEMENT

INITIAL SITE SKETCH 1" = 50'

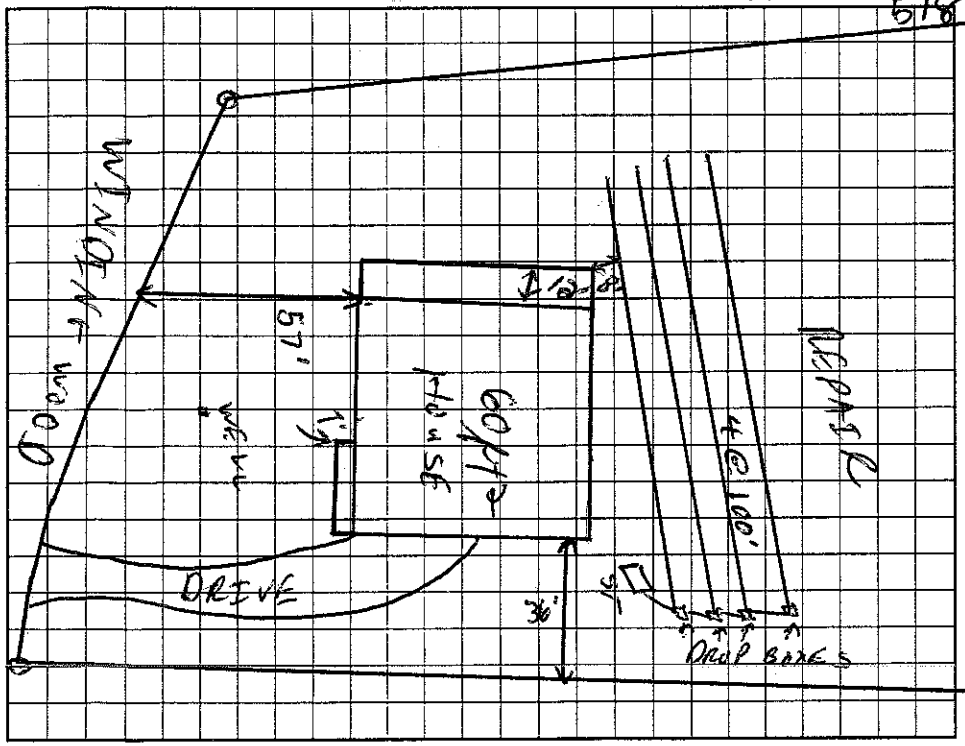

AS BUILT SKETCH

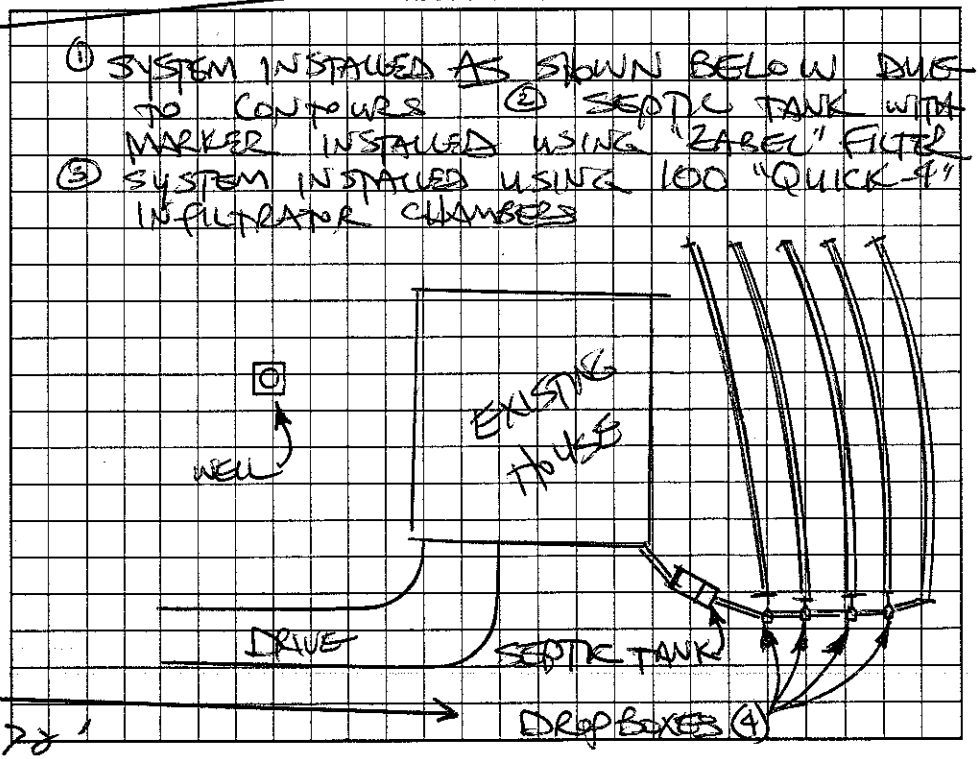

Permit can be suspended or revoked if any false information is supplied toward securing the permit/any unauthorized changes are made to the site/any unauthorized changes are made in the installation of the system. Improvement Permit with plat valid without expiration. Improvement Permit with site plan valid for sixty months. Authorization to Construct is valid for a period equal to that of Improvement Permit – not to exceed sixty months.

Signed: date 4/7/03 Installed by: KEVIN SIGMON

Improvement Permit by: C. RS date 3/27/03 Operation Permit by: STEVE HEDRICK date 12-12-05

Authorization to Construct by: date 5-19-05 Existing System Inspection by: date

HEALTH DEPT. COPY: WHITE OWNER COPY (FINAL): YELLOW OWNER COPY (INITIAL): PINK