CJ BOYLE GRADING 704-902-7308 #15

IREDELL COUNTY HEALTH DEPARTMENT

STATESVILLE 704-878-5305 MOORESVILLE 704-664-5281

IMPROVEMENT PERMIT / AUTHORIZATION TO CONSTRUCT / OPERATION PERMIT / EXISTING SYSTEM INSPECTION

PERMIT# 109831 PIN# ~~4711045067.3~~ 4711-04-5853 DATE 3/27/03

OWNER OR CONTRACTOR BRIDGEWATER CO. LLC PHONE: Business 799-9770 Home

ADDRESS PO BOX 3608 MOORESVILLE NC 28117

LOCATION BUFFALO SHOALS TOWARD LAKE - TL WINDING WOOD - 3rd ON LT

SUBDIVISION RIDGEWOOD BLOCK / SECTION LOT 3 LOT AREA 2.18AC SITE CLASS PS DESIGN FLOW 480GAD L.T.A.R. .25650 NET 2

Septic Tank: 1000 Gallons; STB 1612 Date 1-23-05
Pump Tank: Gallons; PT Date
Pump Make: Model Serial No.
Nitrification Field: No Fields 1 Square Feet 1440 Linear Feet 480
No Lines 4@120' Trench Width 36" Max Trench Bottom Depth 36" Gravel Depth N/A

☑ New System ☐ Repair System Type: I, II, III, IV, V, VI
System Description: GRAVITY 25% REDUCTION
Repair System Description: LP PANEL
Maintenance Agreement Required: ☐ Yes ☑ No

☑ House/Mod. Home No. Bedrooms 4
☐ Mobile Home No. Bathrooms 4
☐ Business No. Employees
☐ Other
☐ Slab ☐ Crawl Space ☑ Basement w/plumbing ☐ Basement wo/plumbing


Water Supply: ☑ Individual ☐ Public ☐ Community

Comments/Conditions: FRENCH DRAIN TO BE INSTALLED 48" DEEP ABOVE DRAIN FIELD AND RAN OUT TO DAY-LIGHT DOWN RIGHT PROPERTY LINE

Comments/Conditions: 5-19-05 - OK'D MOUND WELL, SEPTICS FROM LOT 4 & 23 IS MAINTAINED LL TUFTITE FILTER & MARKERS

1"=50'

INITIAL SITE SKETCH

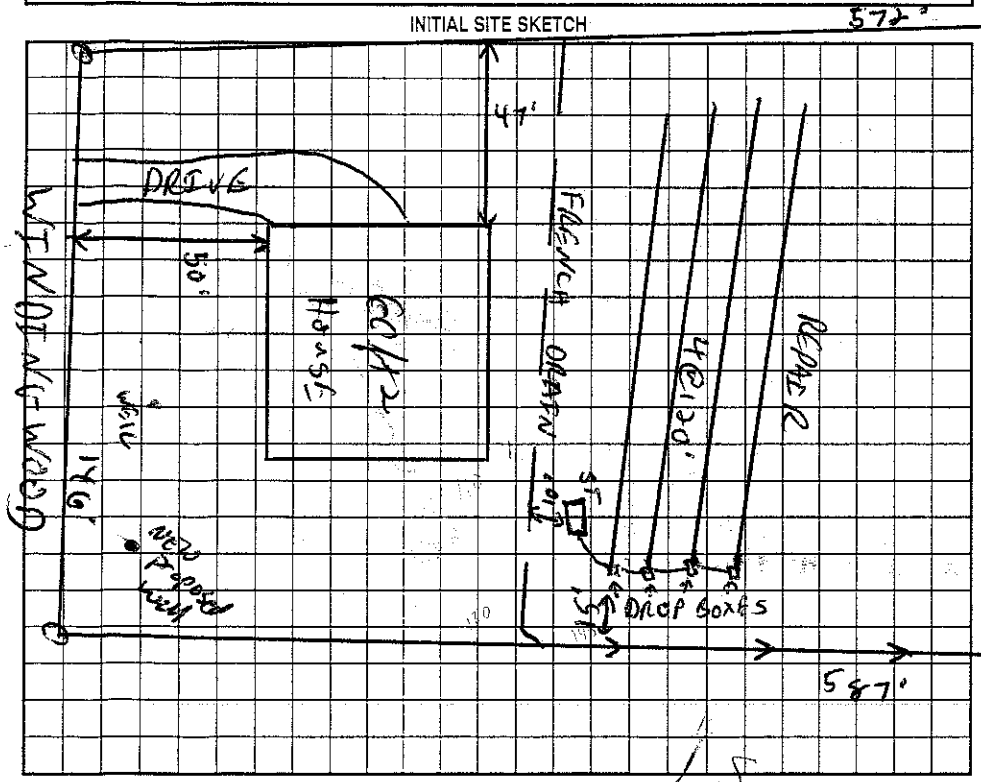

AS BUILT SKETCH

INSTALLED AS DRAWN

Permit can be suspended or revoked if any false information is supplied toward securing the permit/any unauthorized changes are made to the site/any unauthorized changes are made in the installation of the system. Improvement Permit with plat valid without expiration. Improvement Permit with site plan valid for sixty months. Authorization to Construct is valid for a period equal to that of Improvement Permit – not to exceed sixty months.

Signed: date 4/7-03 Installed by: A-1 BACK HOE

Improvement Permit by: date 3/27/03 Operation Permit by: date 7-20-05

Authorization to Construct by: date 12/29/04 Existing System Inspection by: date

HEALTH DEPT. COPY: WHITE OWNER COPY (FINAL): YELLOW OWNER COPY (INITIAL): PINK