THIS PERMIT VOIDS PREVIOUS ISSUED 8-21-95

IREDELL COUNTY HEALTH DEPARTMENT

STATESVILLE 704-878-5305 MOORESVILLE 704-664-5281

IMPROVEMENT PERMIT / CERTIFICATE OF COMPLETION / OPERATION PERMIT / EXISTING SYSTEM INSPECTION

PROPERTY DESCRIPTION NO 23068 DATE 2-12-96 TAX MAP NO 3N-4-A-33 34,35 Watershed: Yes ✓ No

OWNER OR CONTRACTOR DOUG & CHRIS McGUIRE PHONE Business Home (704) 598-8605

ADDRESS 3208 N HIGH GLEN DR STATESVILLE, NC 28677

LOCATION BUFFALO SHOALS TR GRAY ROCK DRIVE, LOTS ON LEFT ~ 1400'

SUBDIVISION GRAYROCK SHOALS BLOCK / SECTION LOT 33 34,35 LOT AREA ~6 ACRES SITE CLASS PS DESIGN FLOW 720 L.T.A.R. 0.35 GPD/FT²

Septic Tank 1500 Gallons: STB 1011 Date 6-19-96

Pump Tank Gallons: PT Date

Pump Make: Model Serial No.

Nitrification: Field No Fields 1 Square Feet 2070 Linear Feet 690

No Lines 6 Trench Width Max Trench Bottom Depth Gravel Depth

✓ New System Repair System Type I II III IV V

System Description: CONVENTIONAL GRAVITY

Repair System Description: CONV. GRAVITY

Maintenance Agreement Required: Yes ✓ No

✓ House/Mod Home No Bedrooms 6

Mobile Home No Bathrooms 2½

Business No Employees

Other


Slab Crawl Space ✓ Basement w/plumbing Basement w/o plumbing

Water Supply: ✓ Individual Community Public WELL

Comments: ① USE FLOW DIVIDER TEE TO SPLIT EFFLUENT INTO TWO SETS OF THREE LINES USING DROP BOXES FOR SERIAL DISTRIBUTION ② LINES ON CONTOUR.

Comments

INITIAL SITE SKETCH

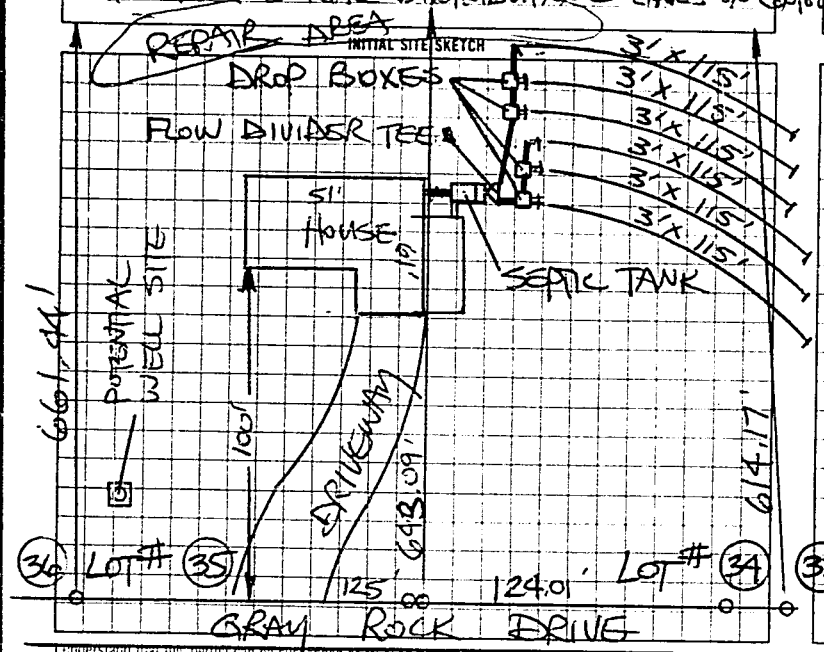

AS BUILT SKETCH

SYSTEM INSTALLED ACCORDING TO INITIAL SITE SKETCH

I understand that this permit can be suspended or revoked if any false information is supplied towards securing the permit, any unauthorized changes are made to the site/any unauthorized changes are made in the installation of the system.

AUTHORIZATION TO CONSTRUCT IS VALID FIVE(5) YEARS FROM DATE OF ISSUANCE. IMPROVEMENT PERMIT HAS NO EXPIRATION DATE.

Signed K & W Nicholsen Inc

Improvement Permit by: STEVE HEDRICK date 2-12-96

Authorization to Construct: STEVE HEDRICK date 2-12-96

Existing System Inspection by:

Installed by TOMMY FRYE

~~Certificate of Completion by~~: date

Operation Permit by STEVE HEDRICK date 8-22-96

HEALTH DEPT COPY WHITE INSPECTION COPY (FINAL) GREEN OWNER COPY (FINAL) YELLOW INSPECTION COPY (INITIAL) PINK