IREDELL COUNTY HEALTH DEPARTMENT

STATESVILLE 704-878-5305 MOORESVILLE 704-664-5281

IMPROVEMENT PERMIT / CERTIFICATE OF COMPLETION / OPERATION PERMIT / EXISTING SYSTEM INSPECTION

PROPERTY DESCRIPTION NO. 25199/82486 DATE 10-3-96 TAX MAP NO. 3 N-4 Watershed: ☑ Yes ☐ No

OWNER OR CONTRACTOR High Shoals Development PHONE: Business 873 2121 Home

ADDRESS 1805 Safrit Rd Statesville WSIV-CA

LOCATION Buffalo Shoals TR Greyrock Dr. on left

SUBDIVISION Grey Rock BLOCK / SECTION LOT 30 LOT AREA 1.9 acres SITE CLASS PS DESIGN FLOW 360 L.T.A.R. 3

Septic Tank: 1000 Gallons; STB 1007 Date 5-18-00

Pump Tank: Gallons; PT Date

Pump Make: Model Serial No.

Nitrification Field: No Fields 1 Square Feet 1200 Linear Feet 400

No Lines 4 Trench Width 36" Max Trench Bottom Depth 36" Gravel Depth 12"

☑ New System ☐ Repair System Type: I II III IV V VI

System Description: Conv. Gravity

Repair System Description: " "

Maintenance Agreement Required: ☐ Yes ☑ No

☐ Slab ☐ Crawl Space ☑ Basement w/plumbing ☐ Basement wo/plumbing

☑ House/Mod. Home No. Bedrooms 3

☐ Mobile Home No. Bathrooms 2

☐ Business No. Employees


☐ Other

Water Supply: ☑ Individual ☐ Community ☐ Public


Comments:

Comments: ① SYSTEM ALTERED AS SHOWN BELOW WITH PRIOR HEALTH DEPT. APPROVAL. ② SEPTIC TANK W/ RISERS AND MARKER INSTALLED USING "POLYLOK" FILTER

INITIAL SITE SKETCH

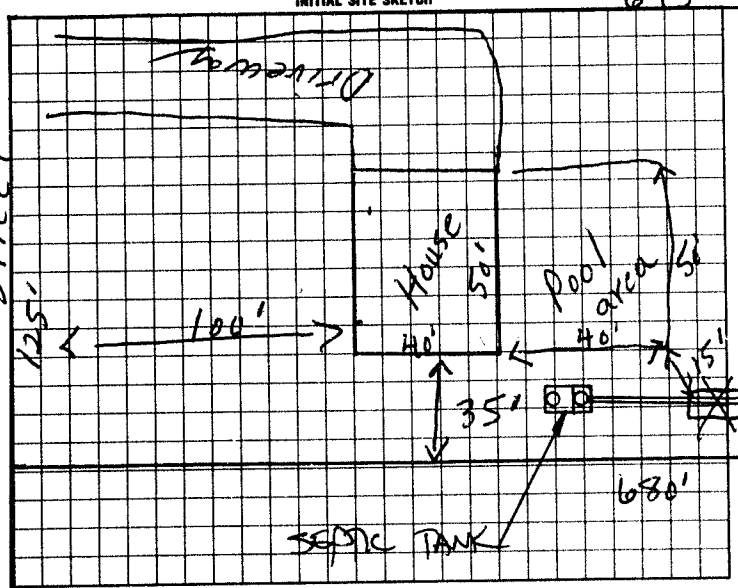

AS BUILT SKETCH

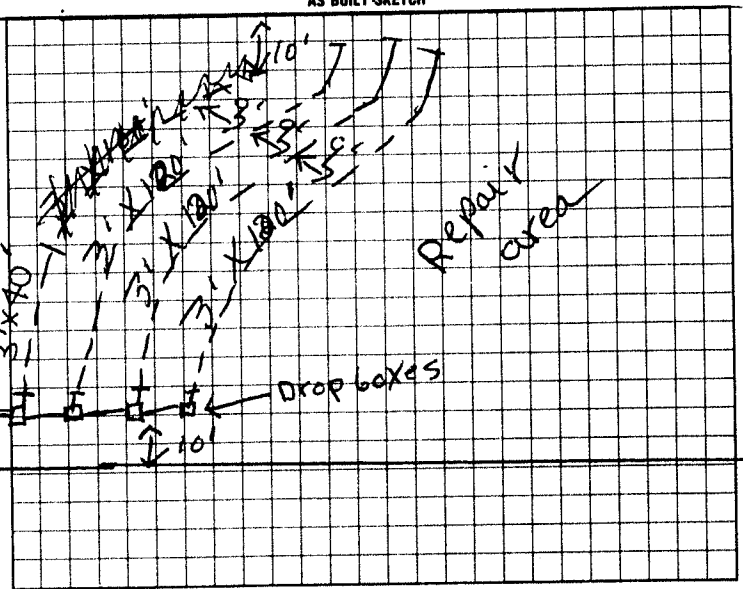

I understand that this permit can be suspended or revoked if any false information is supplied toward securing the permit/any unauthorized changes are made to the site/any unauthorized changes are made in the installation of the system.

Signed: C. Q. Rl / V.P.

Improvement Permit by: R. C. Moore date 10-3-96

Existing System Inspection by: R. C. Moore date 10-3-96

Authorization to Construct

Installed by: JOEY TRAVIS

Certificate of Completion by: STEVE HERRICK date 7-19-00

Operation Permit by: date

HEALTH DEPT. COPY WHITE INSPECTION COPY (FINAL): GREEN OWNER COPY (FINAL): YELLOW INSPECTION COPY (INITIAL): PINK OWNER COPY (INITIAL): GOLD

Authorization to Const. EXPires 60 mos from issue