86529

IREDELL COUNTY HEALTH DEPARTMENT

This Permit Voids all Previous Permits issued 1-25-95

STATESVILLE 704-878-5305 MOORESVILLE 704-664-5281 3-25-94

IMPROVEMENT PERMIT / AUTHORIZATION TO CONSTRUCT / OPERATION PERMIT / EXISTING SYSTEM INSPECTION

PERMIT# 18006 PIN# 3N4A38 DATE July 6, 99

OWNER OR CONTRACTOR Gary Stitner (High Shoals Dev. Inc) PHONE: Business 828 328 3144 Home

ADDRESS 2011 20th St. Pl. NE Hickory NC 28601

LOCATION I-40 (L) Old NC 18 (R) Ruffle Shoals (R) Gray Rock Shoals (Gray Rock Dr) 4th Lot on Left

SUBDIVISION Gray Rock Shoals BLOCK / SECTION LOT 38 LOT AREA 125' x 200' SITE CLASS. 1.5 DESIGN FLOW 360 L.T.A.R. .3 gpd/ft²

Septic Tank: 1000 Gallons: STB 1007 Date 12-28-00

Pump Tank: Gallons: PT Date

Pump Make: Model Serial No.

Nitrification Field: No Fields 1 Square Feet 1200 Linear Feet 300

No Lines 4 @ 80 Trench Width 36" Max Trench Bottom Depth 30"

☒ New System ☐ Repair System Type: I. II. (III) IV. V. VI

System Description: 25% Reduction Gravity

Repair System Description: 25 50% Red. Trail/Imp Pass

Maintenance Agreement Required: ☐ Yes ☒ No

Gravel Depth N/A

☒ House/Mod. Home No. Bedrooms 3

☐ Mobile Home No. Bathrooms 2

☐ Business No. Employees

☐ Other


☐ Slab ☒ Crawl Space ☒ Basement w/plumbing ☐ Basement wo/plumbing

Water Supply: ☒ Individual ☐ Public ☐ Community WELL


Comments/Conditions: 50 Chambers or 30 HBS Sections
Install Lines on contour. Maintain Trench Depth
Keep Tank high

Comments/Conditions:
- Septic Tank Marker Installed
- Poly Lok Filter Installed
- Installed as drawn per Site Sketch
50 Infiltrator Chambers

INITIAL SITE SKETCH

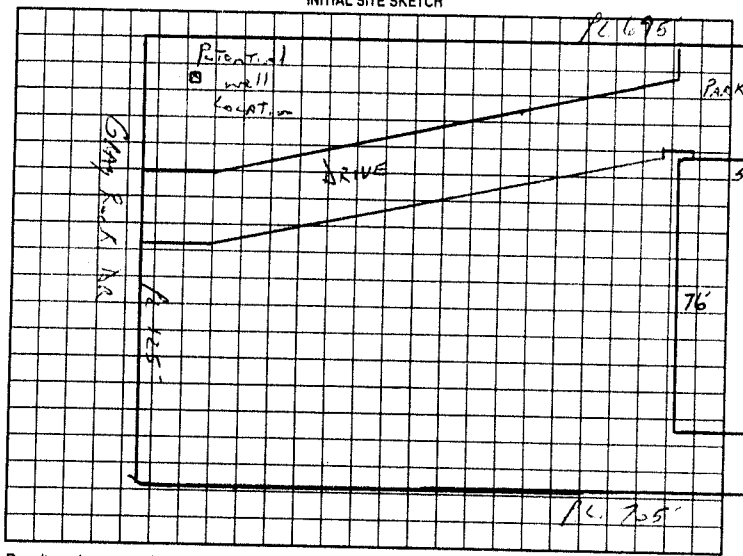

AS BUILT SKETCH

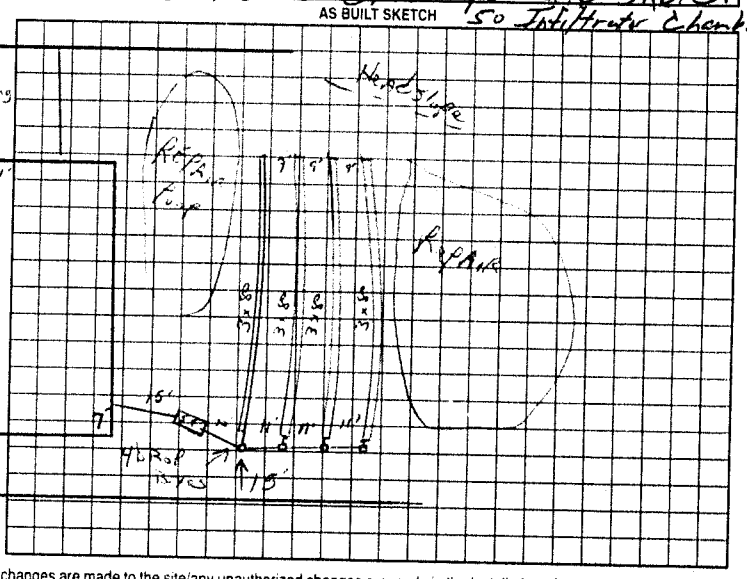

Permit can be suspended or revoked if any false information is supplied toward securing the permit/any unauthorized changes are made to the site/any unauthorized changes are made in the installation of the system. Improvement Permit with plat valid without expiration. Improvement Permit with site plan valid for sixty months. Authorization to Construct is valid for a period equal to that of Improvement Permit - not to exceed sixty months.

Signed: Ray L. Stell date 7-12-99

Improvement Permit by: L.C. Letter date 7-6-99

Authorization to Construct by: L.C. Letter date July 6 99

Installed by: Jody Travis

Operation Permit by: William C. Johnson date 6/8/01

Existing System Inspection by: date

HEALTH DEPT COPY WHITE OWNER COPY (FINAL) YELLOW OWNER COPY (INITIAL) PINK