IREDELL COUNTY HEALTH DEPARTMENT

STATESVILLE 704-878-5305 Ø MOORESVILLE 704-664-5281 CI

IMPROVEMENT PERMIT / AUTHORIZATION TO CONSTRUCT / OPERATION PERMIT / EXISTING SYSTEM INSPECTION

PERMIT# 102943 PIN# 4771-05-8793 DATE 10/30/01

OWNER OR CONTRACTOR Joe Keenan PHONE: Business 704-528-1987 Home

ADDRESS 305 Wagner St. Troutman NC 28166

LOCATION OMR, TR Buffalo Shoals 2½ miles on RT

SUBDIVISION Grayrock Shoals BLOCK / SECTION LOT 46 LOT AREA 1.53 AC SITE CLASS. PS DESIGN FLOW 360 L.T.A.R. 0.5

Septic Tank: 1000 Gallons: STB 1012 Date 8-21-01
Pump Tank: Gallons: PT Date
Pump Make: Model Serial No
Nitrification Field: No Fields 1 Square Feet 1200 Linear Feet 400
No Lines 6 @ 67 Trench Width 36" Max Trench Bottom Depth 36"

☒ New System ☐ Repair System Type: I (II) III IV V VI
System Description: Gravity Conventional
Repair System Description: Same
Maintenance Agreement Required: ☐ Yes ☒ No
Gravel Depth 12"


☒ House/Mod. Home No. Bedrooms 3
☐ Mobile Home No. Bathrooms 2
☐ Business No. Employees
☐ Other
☐ Slab ☒ Crawl Space ☐ Basement w/plumbing ☐ Basement wo/plumbing

Water Supply: ☒ Individual ☐ Public ☐ Community


Comments/Conditions: Install lines on Contour - Keep well 100' from septic system

Comments/Conditions: POLYLOK FILTER & MARKER INSTALLED AS SHOWN

INITIAL SITE SKETCH 1" = 60'

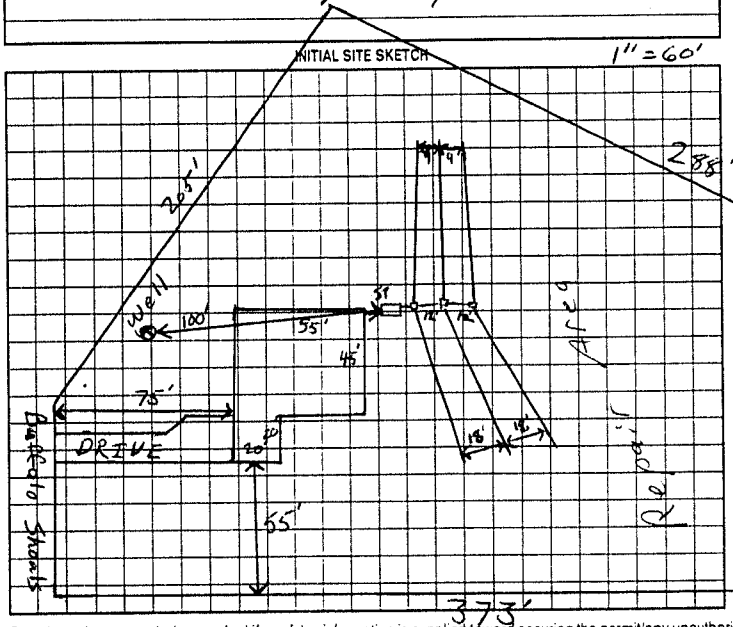

AS BUILT SKETCH

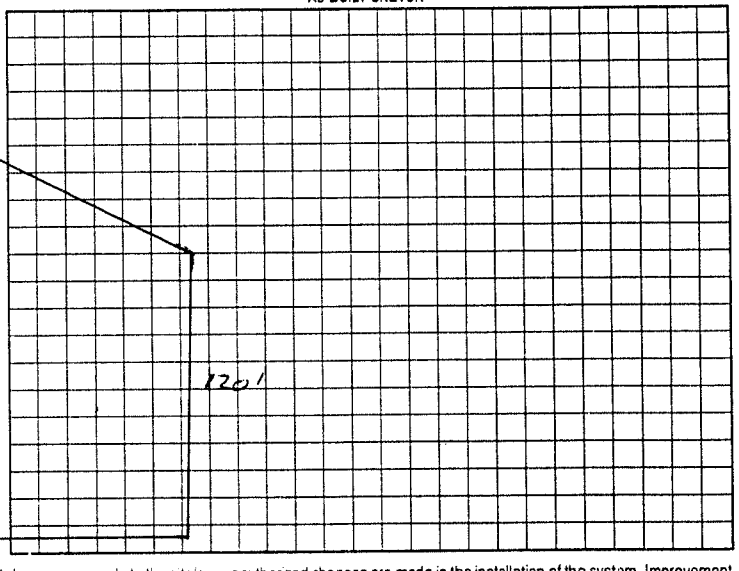

Permit can be suspended or revoked if any false information is supplied toward securing the permit/any unauthorized changes are made to the site/any unauthorized changes are made in the installation of the system. Improvement Permit with plat valid without expiration. Improvement Permit with site plan valid for sixty months. Authorization to Construct is valid for a period equal to that of Improvement Permit - not to exceed sixty months.

Signed: date 11/26/01 Installed by: STEVE JORDAN

Improvement Permit by: RSI date 10/30/01 Operation Permit by: RS date 01-15-02

Authorization to Construct by: RSI date 10/30/01 Existing System Inspection by: date

HEALTH DEPT. COPY: WHITE OWNER COPY (FINAL): YELLOW OWNER COPY (INITIAL): PINK