77631 THIS PERMIT VOIDS PREVIOUS ISSUED 10-16-95

IREDELL COUNTY HEALTH DEPARTMENT

STATESVILLE 704-878-5305 MOORESVILLE 704-664-5281

IMPROVEMENT PERMIT / AUTHORIZATION TO CONSTRUCT / OPERATION PERMIT / EXISTING SYSTEM INSPECTION

PERMIT# 22283 PIN# BN-4-A-10 DATE 3-22-99

OWNER OR CONTRACTOR BRUCE L. WILSON PHONE: Business Home 878-2684

ADDRESS 2046 SALISBURY HWY, STATESVILLE, NC 28677

LOCATION BUFFALO SHOALS ROAD, TR GRAYROCK DRIVE, TENTH LOT ON RIGHT

SUBDIVISION GRAYROCK SHOALS BLOCK / SECTION LOT 10 LOT AREA 132.5' X 300' SITE CLASS PS DESIGN FLOW 360 L.T.A.R. 0.30 GPD/FT²

Septic Tank: 1000 Gallons; STB 774 Date 11-24-98
Pump Tank: Gallons; PT Date
Pump Make: Model Serial No.
Nitrification Field: No. Fields 1 Square Feet EQ. TO 800 Linear Feet 300+
No. Lines 5 1X Trench Width 36" Max Trench Bottom Depth 30"

☑ New System ☐ Repair System Type: I. II (III) IV. V. VI
System Description: 25% REDUCTION GRAVITY
Repair System Description: PUMP / GRAVITY
Maintenance Agreement Required: ☐ Yes ☑ No
Gravel Depth SAND 6" ☐ Slab ☑ Crawl Space ☐ Basement w/plumbing ☐ Basement wo/plumbing


☑ House/Mod. Home ☐ Mobile Home ☐ Business ☐ Other
No. Bedrooms 3 No. Bathrooms 2 No. Employees

Water Supply: ☑ Individual ☐ Public ☐ Community WELL


Comments/Conditions: INSTALL 25% REDUCTION SYSTEM USING FIFTY (50) CHAMBERS OR THIRTY (30) HDS SECTIONS. CONSTRUCT SUBSURFACE INTERCEPT DRAINAGE DITCH AS SHOWN BEGINNING 42" DEEP TO DAYLIGHT

Comments/Conditions:

INITIAL SITE SKETCH

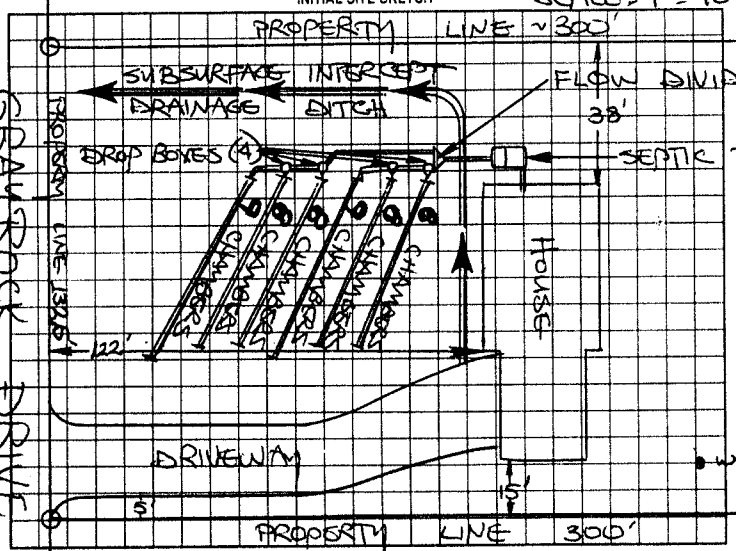

AS BUILT SKETCH

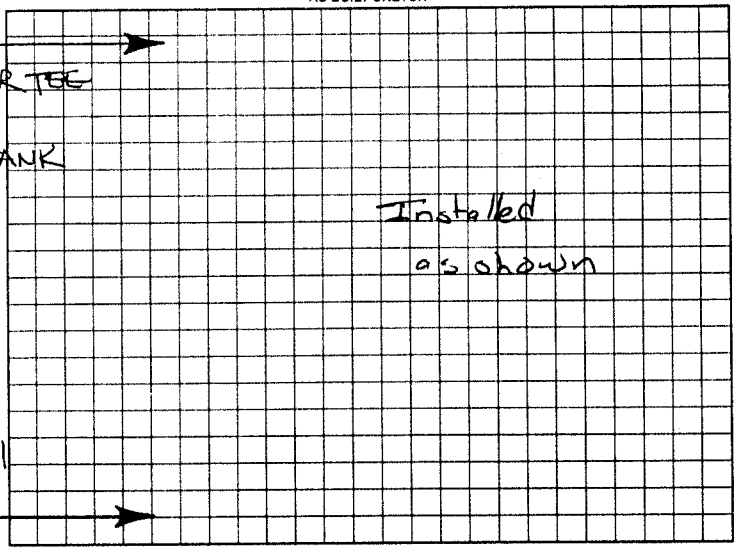

Permit can be suspended or revoked if any false information is supplied toward securing the permit/any unauthorized changes are made to the site/any unauthorized changes are made in the installation of the system. Improvement Permit with plat valid without expiration. Improvement Permit with site plan valid for sixty months. Authorization to Construct is valid for a period equal to that of Improvement Permit – not to exceed sixty months.

Signed: Bruce L. Wilson date 3-25-99 Installed by: James Hudler

Improvement Permit by: STEVE HEDRICK date 3-22-99 Operation Permit by: [illegible] date 3-29-99

Authorization to Construct by: STEVE HEDRICK date 3-22-99 Existing System Inspection by: date

HEALTH DEPT COPY WHITE OWNER COPY (FINAL) YELLOW OWNER COPY (INITIAL) PINK