# IREDELL COUNTY HEALTH DEPARTMENT

STATESVILLE 704-878-5305 MOORESVILLE 704-664-5281

## IMPROVEMENT PERMIT / CERTIFICATE OF COMPLETION / OPERATION PERMIT / EXISTING SYSTEM INSPECTION

PROPERTY DESCRIPTION NO. 23569 (16203Y) DATE 8-1-97 TAX MAP NO. 3N-4-A-9 Watershed: ☐ Yes ☐ No

OWNER OR CONTRACTOR Craig Swan PHONE: Business Home 704 788 3827

ADDRESS 475 High Meadows Dr. Concord, N.C.

LOCATION Buffalo Shoals Rd TR Gray Rock 1/4mi Rt.

SUBDIVISION Gray Rock BLOCK / SECTION LOT 9 LOT AREA 132X300 SITE CLASS. PS DESIGN FLOW 480 L.T.A.R. .3

Septic Tank: 1000 Gallons; STB Date 6-18-97
Pump Tank: Gallons; PT Date
Pump Make: Model Serial No.
Nitrification Field: No Fields 1 Square Feet 1200 Linear Feet 400
No Lines 5 Trench Width 36" Max Trench Bottom Depth 36" Gravel Depth N/A

☑ New System ☐ Repair System Type: I, II, III, IV, V, VI
System Description: Gravity/Chambers
Repair System Description: " "
Maintenance Agreement Required: ☐ Yes ☑ No


☑ House/Mod. Home No. Bedrooms 4
☐ Mobile Home No. Bathrooms 4
☐ Business No. Employees
☐ Other
☐ Slab ☐ Crawl Space ☑ Basement w/plumbing ☐ Basement wo/plumbing

Water Supply: ☑ Individual ☐ Community ☐ Public


Comments:
Permit Replaces one issued To High Shoals Development 4-11-96 Using Gravity Chambers For 4 Bedroom unit.

Comments: Sewage lift Pumped To upper level from Bathroom on basement level

INITIAL SITE SKETCH

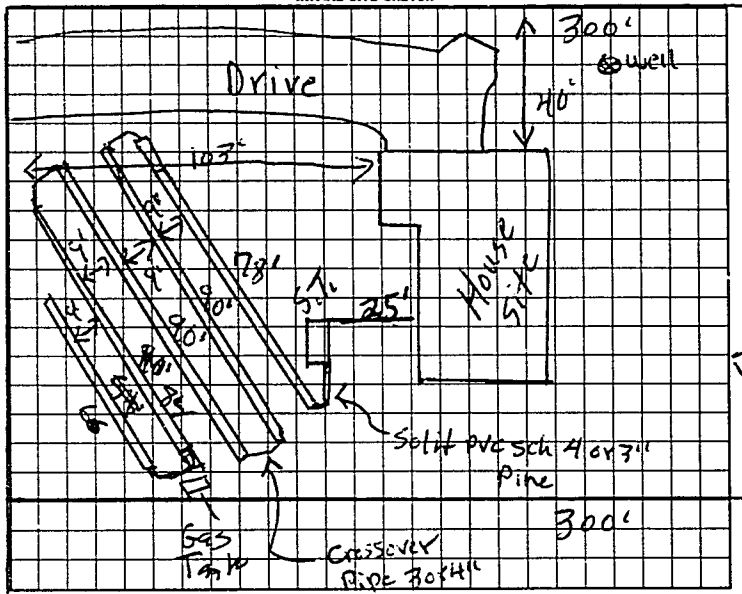


AS BUILT SKETCH

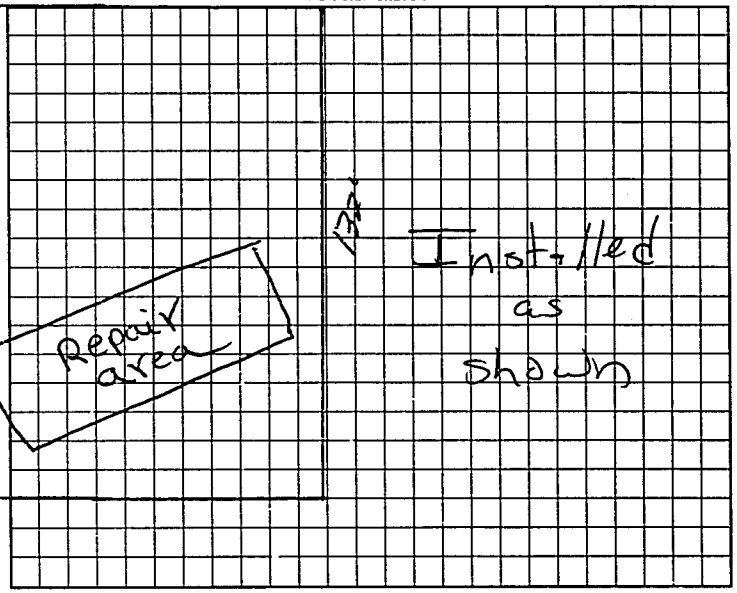


I understand that this permit can be suspended or revoked if any false information is supplied toward securing the permit/any unauthorized changes are made to the site/any unauthorized changes are made in the installation of the system. Improvement Permit is valid for 60 months from date of issuance.

Signed: J. Swan

Improvement Permit by: L.C. Moore date 8-1-97

Authorization to Count by: L.C. Moore date 8-1-97

Existing System Inspection by:

Installed by: FS Ervin

Certificate of Completion by: date

Operation Permit by Mark Coty RS date 9-3-97

HEALTH DEPT. COPY: WHITE INSPECTION COPY (FINAL): GREEN OWNER COPY (FINAL): YELLOW INSPECTION COPY (INITIAL): PINK OWNER COPY (INITIAL): GOLD

to Count.

Authorization to count EXPIRES 60 mos from issue

168200