IREDELL COUNTY HEALTH DEPARTMENT

STATESVILLE 704-878-5305 C.I MOORESVILLE 704-664-5281

IMPROVEMENT PERMIT / AUTHORIZATION TO CONSTRUCT / OPERATION PERMIT / EXISTING SYSTEM INSPECTION

PERMIT# 77238 PIN# 4711 06 8038 DATE 10-17-98

OWNER OR CONTRACTOR High Shoales Development PHONE: Business 873 2121 Home

ADDRESS 1805 Sagriet Rt Statesville, N.C.

LOCATION Buffalo Shoales TR Grayrock 1000' left

SUBDIVISION Grayrock BLOCK / SECTION LOT 39 LOT AREA 1.1 acres SITE CLASS PS DESIGN FLOW 360 L.T.A.R. .33

Septic Tank: 1000 Gallons; STB 312 Date 3-11-03

Pump Tank: Gallons; PT Date

Pump Make: Model Serial No.

Nitrification Field: No Fields 1 Square Feet 1080 Linear Feet 360

No Lines 3 Trench Width 36" Max Trench Bottom Depth 36" Gravel Depth 12"

☑ New System ☐ Repair System Type: I, II, III, IV, V, VI

System Description: Conv. Gravity

Repair System Description:

Maintenance Agreement Required: ☐ Yes ☑ No

☑ House/Mod. Home No. Bedrooms 3

☐ Mobile Home No. Bathrooms 2

☐ Business No. Employees

☐ Other

☐ Slab ☑ Crawl Space ☑ Basement w/plumbing ☐ Basement wo/plumbing


Water Supply: ☑ Individual ☐ Public ☐ Community

Comments:/Conditions:


Comments:/Conditions:

- ST. Marker, Riser Installed
- Label Filter Installed
House not built at time of Septic Installation

INITIAL SITE SKETCH

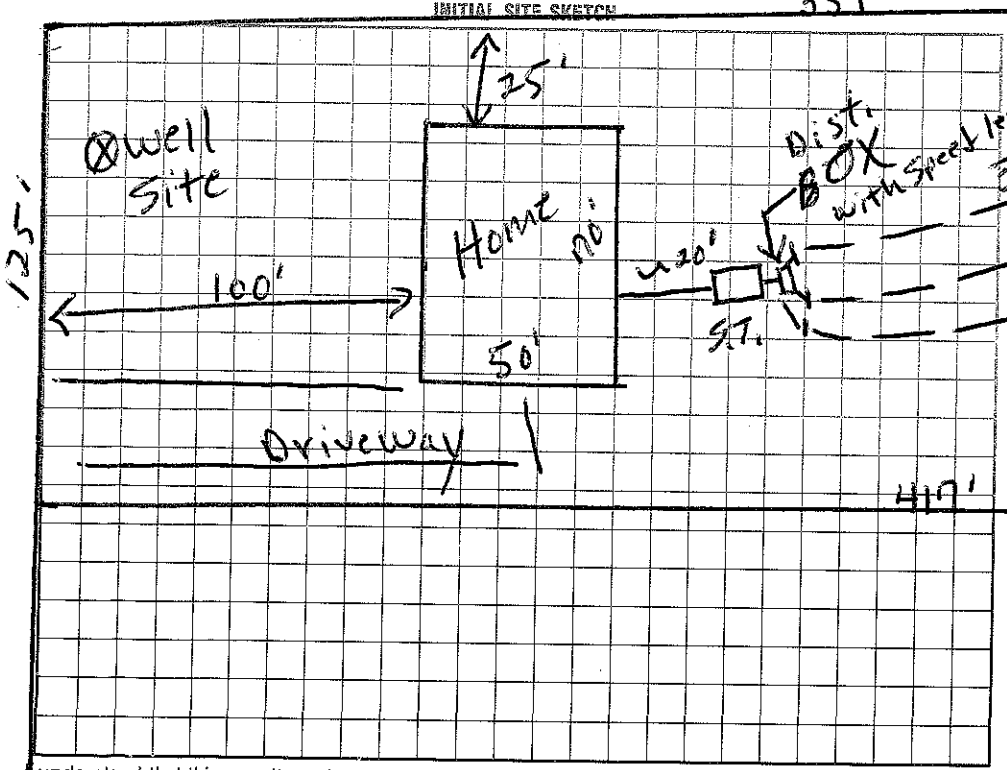

AS BUILT SKETCH

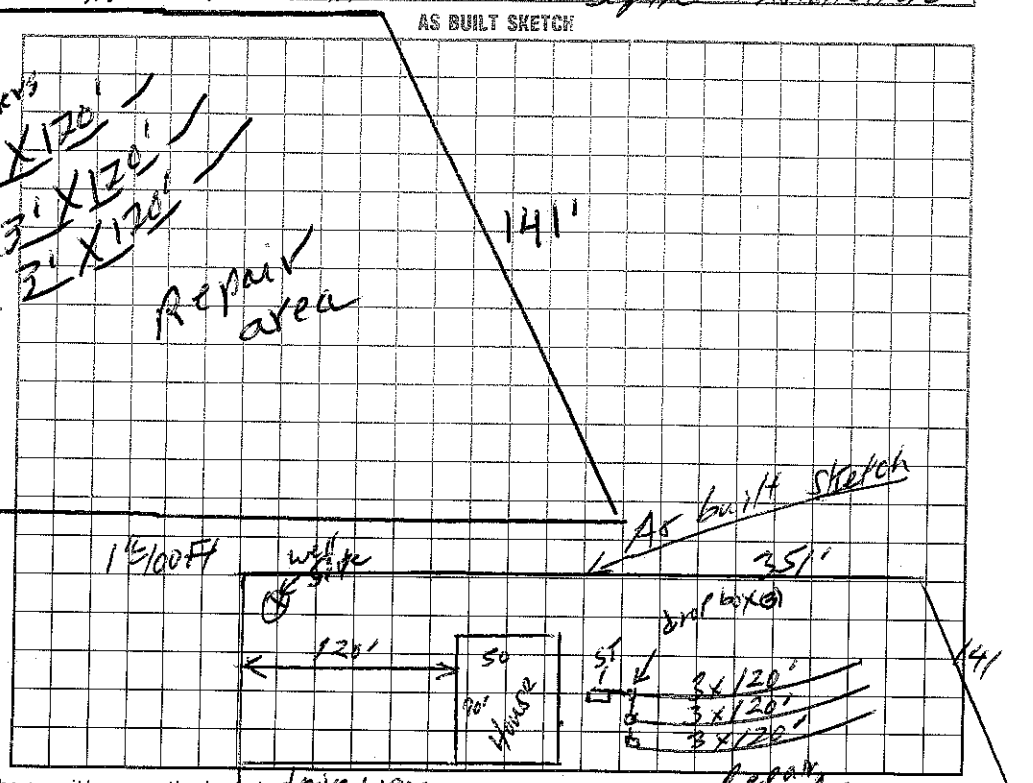

I understand that this permit can be suspended or revoked if any false information is supplied toward securing the permit/any unauthorized ~~changes are made to the~~ site/any unauthorized changes are made in the installation of the system. Improvement Permit with plat valid without expiration. Improvement Permit with site plan valid for sixty months. Authorization to Construct is valid for a period equal to that of Improvement Permit – not to exceed sixty months.

Signed: C. O. M. V.P. date 10-21-98 Installed by: Madison Grading

Improvement Permit by: R.C. moore date 10-17-98 Operation Permit by: William O. Johnson date 9/17/03

Authorization to Construct by: R.C. moore date 10-17-98 Existing System Inspection by: date

HEALTH DEPT. COPY: WHITE INSPECTION COPY (FINAL): GREEN OWNER COPY (FINAL): YELLOW INSPECTION COPY (INITIAL): PINK OWNER COPY (INITIAL): GOLD