This permit Voids previously issued permit dated 3/19/02

IREDELL COUNTY HEALTH DEPARTMENT

STATESVILLE 704-878-5305 MOORESVILLE 704-664-5281

IMPROVEMENT PERMIT / AUTHORIZATION TO CONSTRUCT / OPERATION PERMIT / EXISTING SYSTEM INSPECTION

PERMIT# 105091 PIN# 4711-06-8439 DATE 6/24/02

OWNER OR CONTRACTOR High Shoals Development Inc. PHONE: Business (704) 873-7700 Home —

ADDRESS 1805 Sapret Rd. Statesville, N.C 28625

LOCATION Buffalo Shoals Rd, 3½ miles past Tyler Crossroads, (R) on Grayrock, 8th lot on right

SUBDIVISION Grayrock Shoals BLOCK / SECTION — LOT 8 LOT AREA .91 Acres SITE CLASS P5 DESIGN FLOW 360 L.T.A.R. .35

Septic Tank: 1,000 Gallons: STB 825 Date 04/04/02
Pump Tank: _____ Gallons: PT _____ Date _____
Pump Make: _____ Model Eqm. To Serial No _____
Nitrification Field: No Fields 1 Square Feet 1029 Linear Feet [illegible]260
No Lines 3 Trench Width 36" Max Trench Bottom Depth 30" Gravel Depth —

X New System ☐ Repair System Type I II (III) IV V VI
System Description: Gravity, 25% Reduction
Repair System Description: Gravity/Pump, 25% Red.
Maintenance Agreement Required: ☐ Yes X No
☐ Slab ☐ Crawl Space X Basement w/plumbing ☐ Basement wo/plumbing


X House/Mod. Home No. Bedrooms 3
☐ Mobile Home No. Bathrooms 3
☐ Business No. Employees ____
☐ Other _____

Water Supply: X Individual ☐ Public ☐ Community


Comments/Conditions: ① Keep System 100 Ft From Well ② Install lines on Contour ③ Keep Septic lines 25 ft above drainage way

Comments/Conditions: INSTALLED AS SHOWN BELOW. WITH PRIOR HEALTH DEPARTMENT APPROVAL - Installed with Polylock Filter & Septic [illegible] MARKER

INITIAL SITE SKETCH

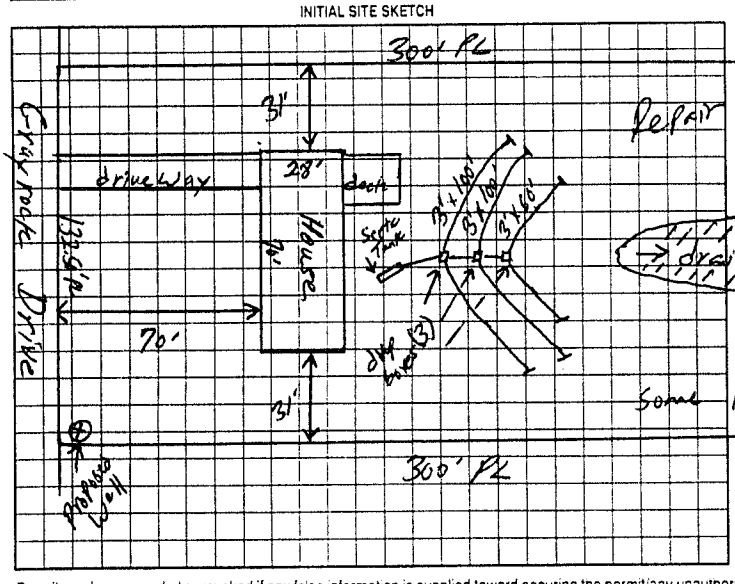

AS BUILT SKETCH

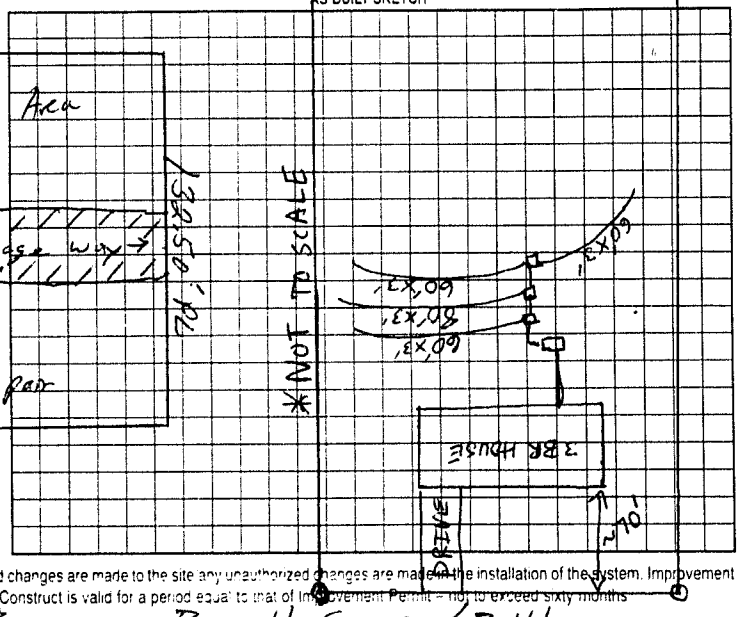

Permit can be suspended or revoked if any false information is supplied toward securing the permit/any unauthorized changes are made to the site any unauthorized changes are made in the installation of the system. Improvement Permit with plat valid without expiration. Improvement Permit with site plan valid for sixty months. Authorization to Construct is valid for a period equal to that of Improvement Permit – not to exceed sixty months

Signed: H C Houston date 6-24-2002 installed by Russell Smyre / Builder

Improvement Permit by: William O. Johnson date 6/24/02 Operation Permit by: Patrick Mitchell date 07/02/02

Authorization to Construct by: William O. Johnson date 6/24/02 Existing System Inspection by: [redacted] date [redacted]

HEALTH DEPT COPY WHITE OWNER COPY (FINAL) YELLOW OWNER COPY (INITIAL) PINK