073695

IREDELL COUNTY HEALTH DEPARTMENT

STATESVILLE 704-878-5305 MOORESVILLE 704-664-5281

IMPROVEMENT PERMIT / CERTIFICATE OF COMPLETION / OPERATION PERMIT / EXISTING SYSTEM INSPECTION

PROPERTY DESCRIPTION NO. 25474 DATE 11-18-96 TAX MAP NO. 3N-4-A-12 Watershed: ☐ Yes ☐ No

OWNER OR CONTRACTOR High Shoals Development PHONE: Business 873-7121 Home

ADDRESS 1805 Sanford Rd

LOCATION Buffalo Shoals TR Grey Rock Dr. 800' Rt

SUBDIVISION Grey Rock BLOCK / SECTION LOT 7 LOT AREA 1 acre SITE CLASS. P3 DESIGN FLOW 360 L.T.A.R.

Septic Tank: 1000 Gallons; STB 774 Date 5-21-98

Pump Tank: Gallons; PT Date

Pump Make: Model Serial No. 400

Nitrification Field: No Fields 1 Square Feet 1080 Linear Feet ~~360~~

No Lines 3 Trench Width 36" Max Trench Bottom Depth 36" Gravel Depth 12"

☐ New System ☐ Repair System Type: I, II, III, IV, V, VI

System Description: Conv. Gravity

Repair System Description: " "

Maintenance Agreement Required: ☐ Yes ☒ No

☐ Slab ☒ Crawl Space ☐ Basement w/plumbing ☐ Basement wo/plumbing

☐ House/Mod. Home ☐ Mobile Home ☐ Business ☐ Other


No. Bedrooms 3 No. Bathrooms 2½ No. Employees

Water Supply: ☐ Individual ☐ Community ☐ Public


Comments:

Comments: 9/17 House changed from crawl space to ~~House with~~ Basement w/plumbing Neighboring well - needed to keep 50 Ft from it

INITIAL SITE SKETCH

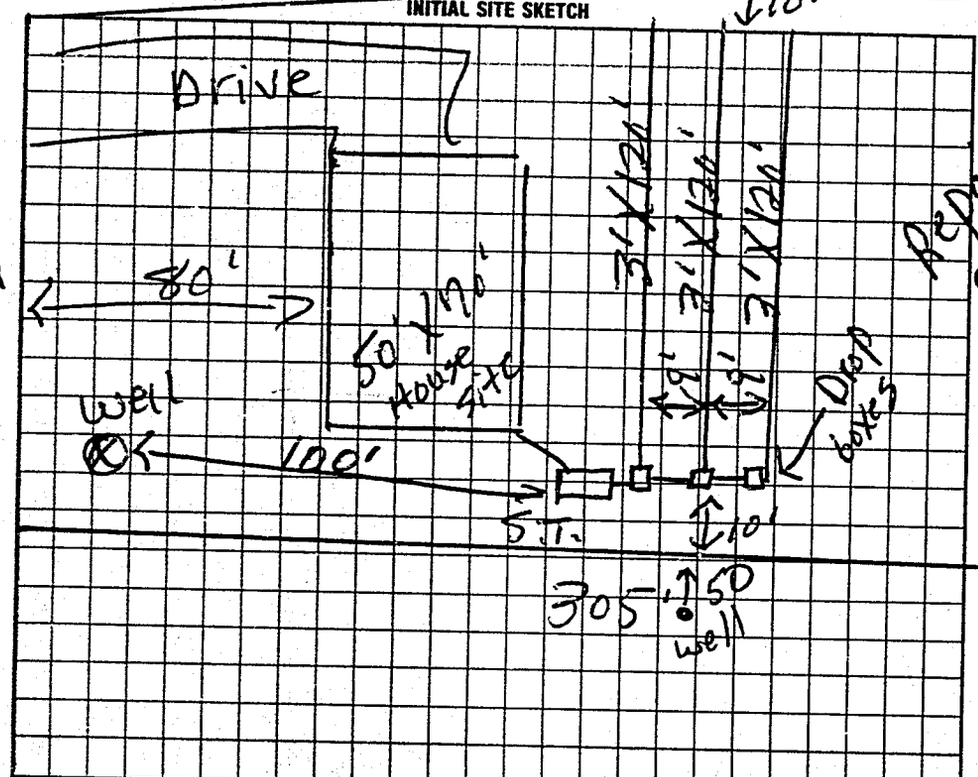

AS BUILT SKETCH

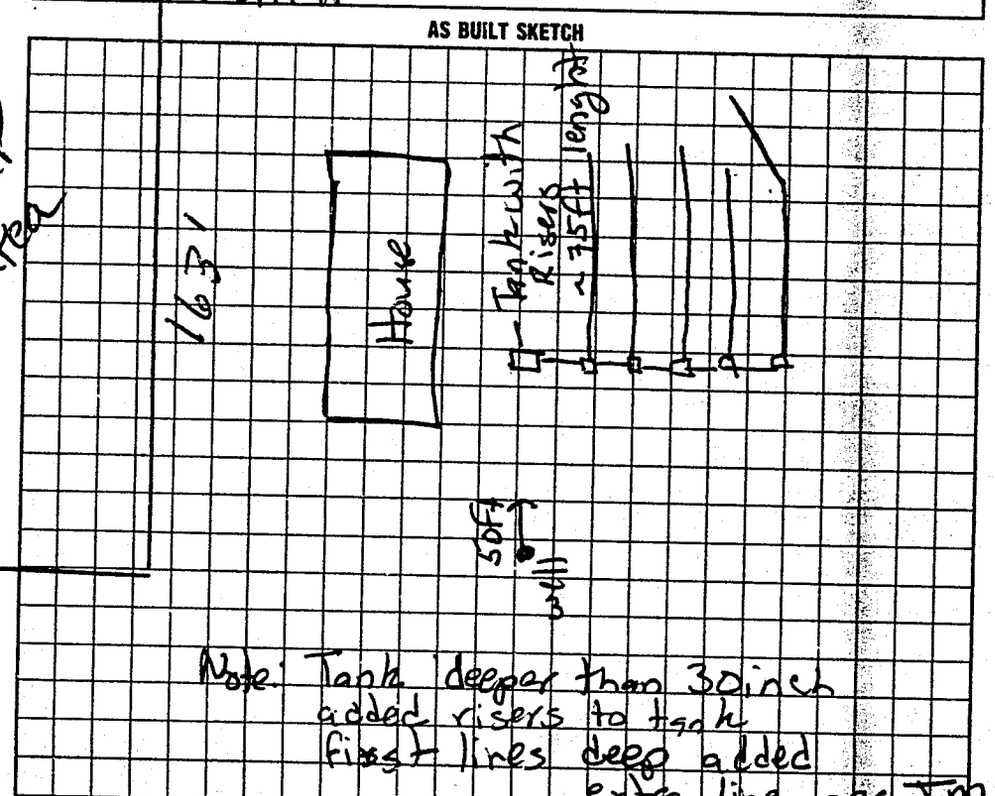

Note: Tank deeper than 30 inch added risers to tank first lines deep added extra line per JM

I understand that this permit can be suspended or revoked if any false information is supplied toward securing the permit/any unauthorized changes are made to the site/any unauthorized changes are made in the installation of the system.

Signed: C. D. Nl U.P

Improvement Permit by: L.C. Moore date 11-18-96

Authorization to Construct/Existing System Inspection by: L.C. Moore date 11-18-96

Installed by: Caldwell Grading

Certificate of Completion by: N/A date

Operation Permit by: Mark C.O.S. RS date 9-18-98

Authorization to Construct. EXPIRES 60 mos from issue

HEALTH DEPT. COPY: WHITE INSPECTION COPY (FINAL): GREEN OWNER COPY (FINAL): YELLOW INSPECTION COPY (INITIAL): PINK OWNER COPY (INITIAL): GOLD