JOHN SHEDDON This voids permit dated 3-26-98. Redrawn.

IREDELL COUNTY HEALTH DEPARTMENT

STATESVILLE 704-878-5305 MOORESVILLE 704-664-5281

IMPROVEMENT PERMIT / AUTHORIZATION TO CONSTRUCT / OPERATION PERMIT / EXISTING SYSTEM INSPECTIO

PERMIT# 072286 PIN# 4711 326122 4711-11-8161 DATE 5/25/01

OWNER OR CONTRACTOR Lake Norman Properties PHONE: Business (704) 847-6606 Home

ADDRESS P.O. Box 1627 Mathews, NC 28106

LOCATION Buffalo Shoals Rd, (L) Laurel Cove; (R) Harborgate; (L) (R) Harbor Watch (L) Harbor ridge at End

SUBDIVISION Harbor Watch BLOCK / SECTION 1 LOT 140 LOT AREA .79 Acres SITE CLASS. PS DESIGN FLOW 480 L.T.A.R. .25

Septic Tank: 1,000 Gallons: STB 1007 Date 10-22-01

Pump Tank: 1,000 Gallons: PT 224 Date 11-1-01

Pump Make: Hydromatic Model SME50R1 Serial No. 3-00

Nitrification Field: No Fields 1 Square Feet [illegible] Linear Feet 320

No Lines 5 Trench Width 24" Max Trench Bottom Depth 36" [illegible] Depth NA

☒ New System ☐ Repair System Type: I, II, III, (IV) V, VI

System Description: Pump to Pressure dosed Panels

Repair System Description: Pump to Pressure dose PPBPS

Maintenance Agreement Required: ☒ Yes ☐ No

☒ House/Mod. Home ☐ Mobile Home ☐ Business ☐ Other


No. Bedrooms 4 No. Bathrooms 3 No. Employees

☐ Slab ☐ Crawl Space ☒ Basement w/plumbing ☐ Basement wo/plumbing

Water Supply: ☒ Individual ☐ Public ☐ Communi

Comments/Conditions: (1) Install 50% Reduction System using 73 Low Pressure PPBPS Panels (3@ 15 + 2@ 14). (2) Keep System 15 From House, 10 ft From Property line (3) Install on Contour (4) See attached Sheets for Pump & low pressure requirements (5) A management Contract Shall be executed between System owner and a management entity prior to issuance of operation permit.

INITIAL SITE SKETCH,

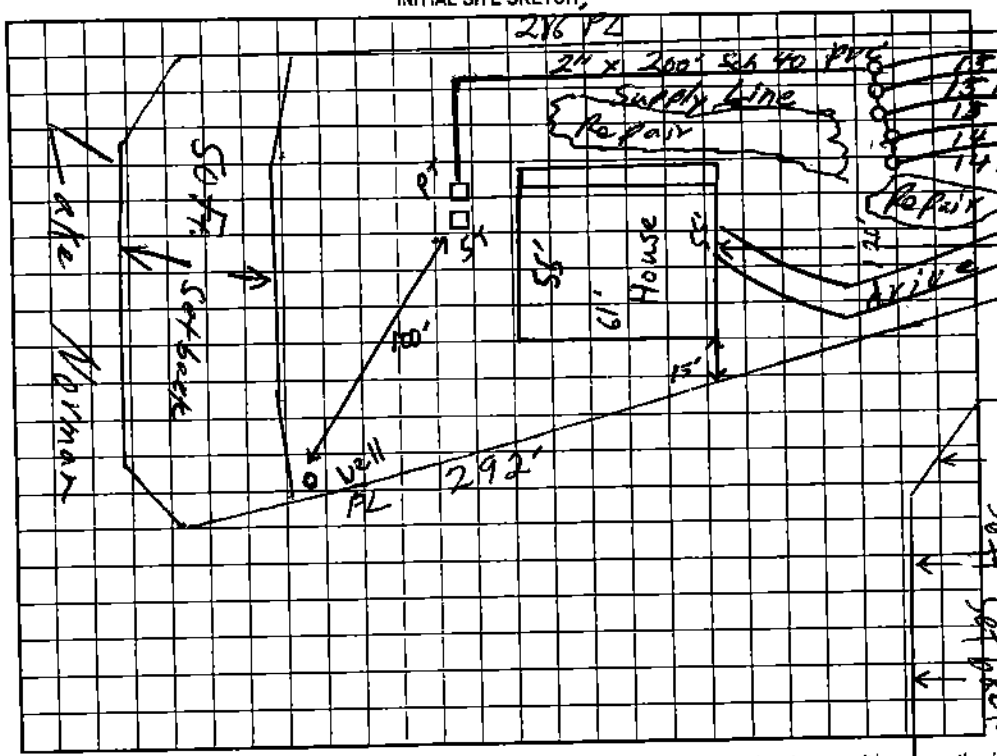


AS BUILT SKETCH

2-8-02 Lines Inspected, grade Panels okay. Lines not on Contour as by 2 Lines are deep. (2'5" & 3') bottom of T

2-11-02 - Pressure check Tokay

2-13-02 - Ele. & Alarm - okay

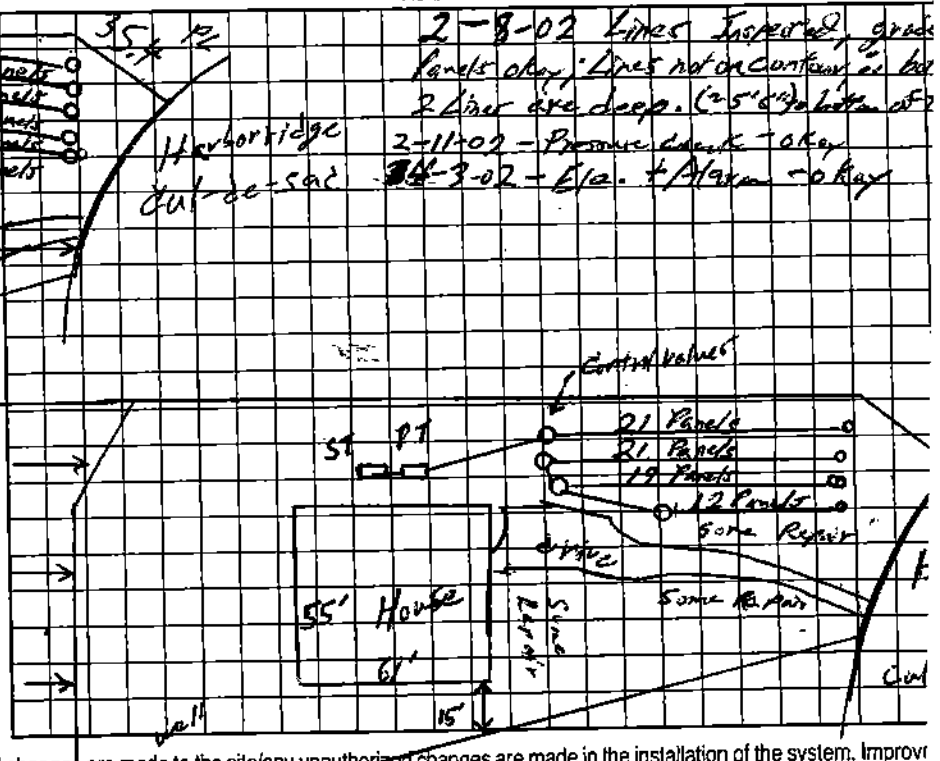

Permit can be suspended or revoked if any false information is supplied toward securing the permit/any unauthorized changes are made to the site/any unauthorized changes are made in the installation of the system. Improvr Permit with plat valid without expiration. Improvement Permit with site plan valid for sixty months. Authorization to Construct is valid for a period equal to that of Improvement Permit – not to exceed sixty months.

Signed: [signature] date 6-14-01 Installed by: Sammy Shoemaker

Improvement Permit by: William O. Johnson date 6/14/01 Operation Permit by: William O. Johnson date 4/3/02

Authorization to Construct by: William O. Johnson date 6/14/01 Existing System Inspection by: date

OWNER COPY (FINAL): YELLOW OWNER COPY (INITIAL): PINK