IMPROVEMENT PERMIT / AUTHORIZATION TO CONSTRUCT / OPERATION PERMIT / EXISTING SYSTEM INSPECTION

PERMIT# 1100.39 PIN# ~~47110'6267.14~~ 491-13-7808 DATE 3/25/03

APPLICANT OR CONTRACTOR BRIDGEWATER CO. LLC PHONE: Business 799-9770 Home

ADDRESS PO BOX 3608 MOORESVILLE NC 28117

LOCATION BUFFALO SHOALS TOWARD LAKE - TL WINDING WOOD - 14th ON LT

SUBDIVISION RIDGEWOOD BLOCK / SECTION ____ LOT 14 LOT AREA 1.66 AC SITE CLASS PS DESIGN FLOW 480GPD L.T.A.R. .36/.40/FT²

Septic Tank: 1000 Gallons; STB 820 Date 10-2-05

Pump Tank: ____ Gallons; PT ____ Date ____

Pump Make: ____ Model ____ Serial No. ____

Application Field: No Fields 1 Square Feet 1605 Linear Feet 535

Trenches 5@107' Trench Width 36" Max Trench Bottom Depth 36" Gravel Depth 12"

☑ New System ☐ Repair System Type: I II III IV V VI

System Description: GRAVITY CONVENTIONAL

Repair System Description: GRAV. 25% REDUCTION

Maintenance Agreement Required: ☐ Yes ☑ No

☑ House/Mod. Home No. Bedrooms 4

☐ Mobile Home No. Bathrooms 4

☐ Business No. Employees ____

☐ Other ____

☐ Slab ☐ Crawl Space ☐ Basement w/plumbing ☑ Basement wo/plumbing

Water Supply: ☑ Individual ☐ Public ☐ Community


Comments:/Conditions: STAIRS OF PAVER Brick Patios

NO FOUNDATION PER OWNER


Pergola will be 5'+ OFF Septic & WATER Features will be 15'+

Comments:/Conditions: Approved 64'x60' HOUSE PLAN THAT IS 4 BEDROOMS ON 4-19-05. SIDE SETBACK IS CHANGED TO 62' NOT 106'. FRONT IS STILL 50' OFF ROAD

INITIAL SITE SKETCH 1"=50' OFF Septic

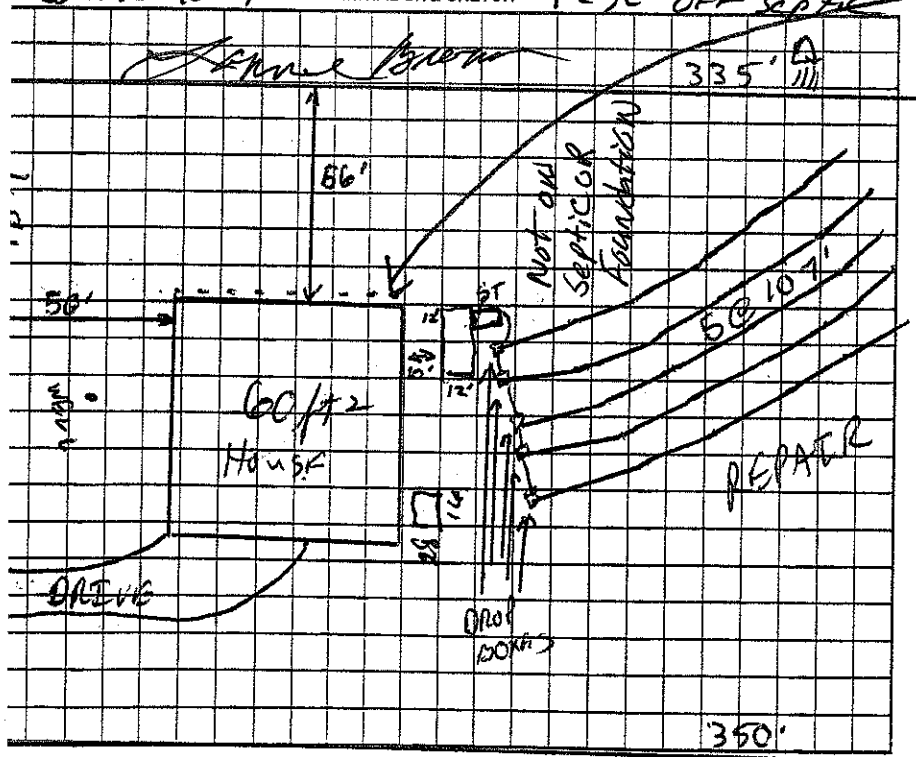

AS BUILT SKETCH

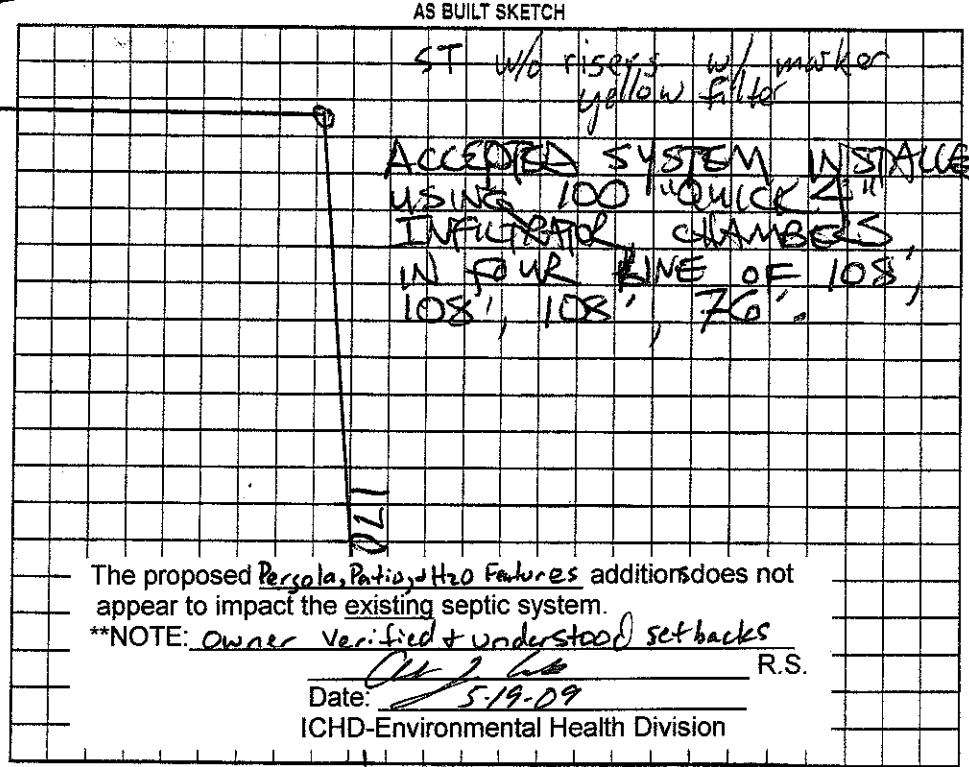

The proposed Pergola, Patio, H2O Features additions does not appear to impact the existing septic system.

**NOTE: Owner Verified + understood setbacks

R.S.

Date: 5-19-09

ICHD-Environmental Health Division

can be suspended or revoked if any false information is supplied toward securing the permit/any unauthorized changes are made to the site/any unauthorized changes are made in the installation of the system. Improvement with plat valid without expiration. Improvement Permit with site plan valid for sixty months. Authorization to Construct is valid for a period equal to that of Improvement Permit – not to exceed sixty months.

Site: ____ date 4/7/05 Installed by: RAY'S (ROBBIE RAY)

Improvement Permit by: C. ____ KS date 3/25/03 Operation Permit by: STEVE HEDRICK date 12-28-05

Authorization to Construct by: ____ date 4/19/05 Existing System Inspection by: ____ date ____

HEALTH DEPT. COPY: WHITE OWNER COPY (FINAL): YELLOW OWNER COPY (INITIAL): PINK