+130

IREDELL COUNTY HEALTH DEPARTMENT

STATESVILLE 704-878-5305 (C) MOORESVILLE 704-664-5281

IMPROVEMENT PERMIT / AUTHORIZATION TO CONSTRUCT / OPERATION PERMIT / EXISTING SYSTEM INSPECTION

PERMIT# 109838 PIN# ~~4704826756~~ 4711-14-5917 DATE 3/28/03

OWNER OR CONTRACTOR BRIDGEWATER CO. LLC PHONE: Business 799-9770 Home

ADDRESS PO BOX 3608 MOORESVILLE NC 28117

LOCATION BUFFALO SHOALS TOWARD LAKE - TL WINDING-WOOD DR. - 8th LOT ON LT.

SUBDIVISION RIDGEWOOD BLOCK / SECTION LOT 8 LOT AREA 2.16 AC SITE CLASS. PS DESIGN FLOW 480GPD L.T.A.R. .36GPD/FT

Septic Tank: 1000 Gallons; STB 760 Date 8-19-06
Pump Tank: 1000 Gallons; PT 303 Date 12-9-06
Pump Make: ZOELLER Model BN 140 Serial No.
Nitrification Field: No Fields 1 Square Feet 1200 Linear Feet 400
No Lines 3@133' Trench Width 36" Max Trench Bottom Depth 36" Gravel Depth 6/4

☑ New System ☐ Repair System Type: I, II, III, IV, V, VI
System Description: PUMP 25% REDUCTION
Repair System Description: SAME
Maintenance Agreement Required: ☐ Yes ☑ No

☑ House/Mod. Home No. Bedrooms 4
☐ Mobile Home No. Bathrooms 4
☐ Business No. Employees
☐ Other


☐ Slab ☐ Crawl Space ☑ Basement w/plumbing ☐ Basement wo/plumbing

Water Supply: ☑ Individual ☐ Public ☐ Community

Comments:/Conditions:

Comments:/Conditions: SEPTIC TANK W/ RISERS INSTALLED USING RED "Poly LOK" FILTER

INITIAL SITE SKETCH 1" = 100'

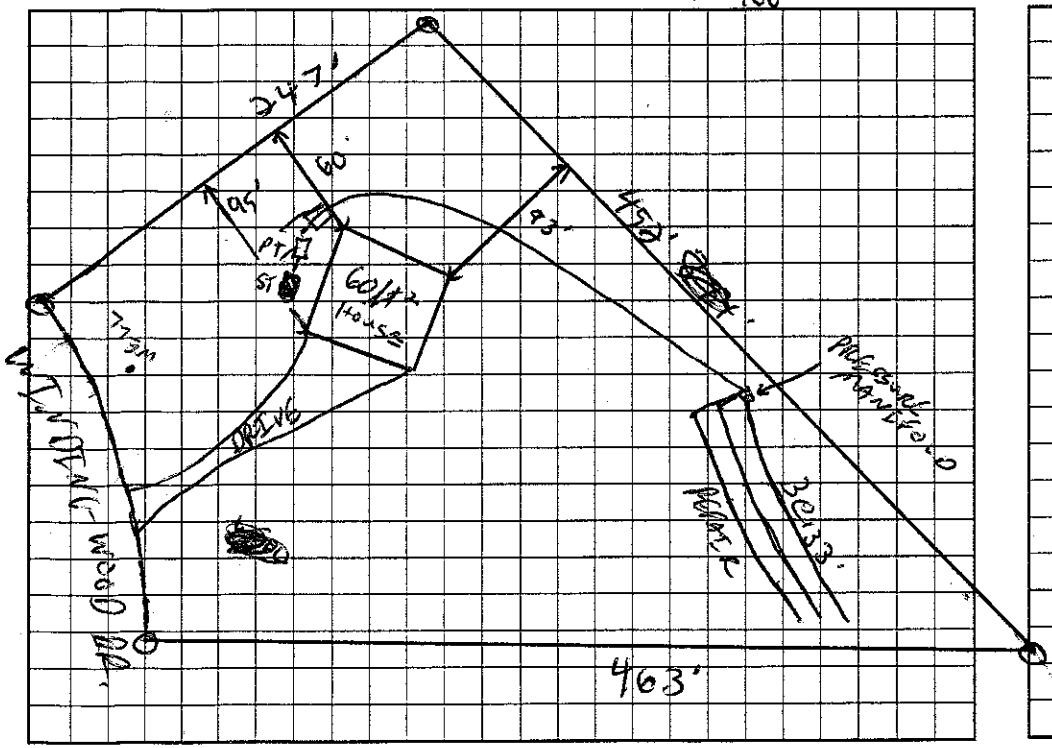

AS BUILT SKETCH

AS SHOWN

Permit can be suspended or revoked if any false information is supplied toward securing the permit/any unauthorized changes are made to the site/any unauthorized changes are made in the installation of the system. Improvement Permit with ~~plat~~ valid without expiration. Improvement Permit with site plan valid for sixty months. Authorization to Construct is valid for a period equal to that of Improvement Permit – not to exceed sixty months.

Signed: date 4/7/03 Installed by: SAMMY REAVIS

Improvement Permit by: date 3/28/03 Operation Permit by: STEVE HENDRICK date 3-22-07

Authorization to Construct by: date 4-20-06 Existing System Inspection by: date

HEALTH DEPT. COPY: WHITE OWNER COPY (FINAL): YELLOW OWNER COPY (INITIAL): PINK