IREDELL COUNTY HEALTH DEPARTMENT

STATESVILLE 704-878-5305 (C) MOORESVILLE 704-664-5281

IMPROVEMENT PERMIT / AUTHORIZATION TO CONSTRUCT / OPERATION PERMIT / EXISTING SYSTEM INSPECTION

+130

PERMIT# 109838 PIN# ~~4704826786~~ 4711-14-5912 DATE 3/28/03

OWNER OR CONTRACTOR BRIDGEWATER U. LLC PHONE: Business 799-9770 Home

ADDRESS PO BOX 3608 MOORESVILLE NC 28117

LOCATION BUFFALO SHOALS TOWARD LAKE - TL WENDING-WOOD DR. - 8th LOT ON LT.

SUBDIVISION RIDGEWOOD BLOCK / SECTION LOT 8 LOT AREA 2.16 AC SITE CLASS. PS DESIGN FLOW 480GPD L.T.A.R. .3690/K=2

Septic Tank: 1000 Gallons; STB 760 Date 8-19-06
Pump Tank: 1000 Gallons; PT 303 Date 12-9-06
Pump Make: ZOELLER Model BN 140 Serial No.
Nitrification Field: No Fields 1 Square Feet 1200 Linear Feet 400
No Lines 3@133' Trench Width 36" Max Trench Bottom Depth 36" Gravel Depth 1/4

☑ New System ☐ Repair System Type: I, II, (III) IV, V, VI
System Description: PUMP 25% REDUCTION
Repair System Description: SAME
Maintenance Agreement Required: ☐ Yes ☑ No


☑ House/Mod. Home No. Bedrooms 4
☐ Mobile Home No. Bathrooms 4
☐ Business No. Employees
☐ Other
☐ Slab ☐ Crawl Space ☑ Basement w/plumbing ☐ Basement wo/plumbing

Water Supply: ☑ Individual ☐ Public ☐ Community

Comments/Conditions:

Comments/Conditions: SEPTIC TANK W/ RISERS INSTALLED USING RED "Poly Lok" FILTER

INITIAL SITE SKETCH 1" = 100'

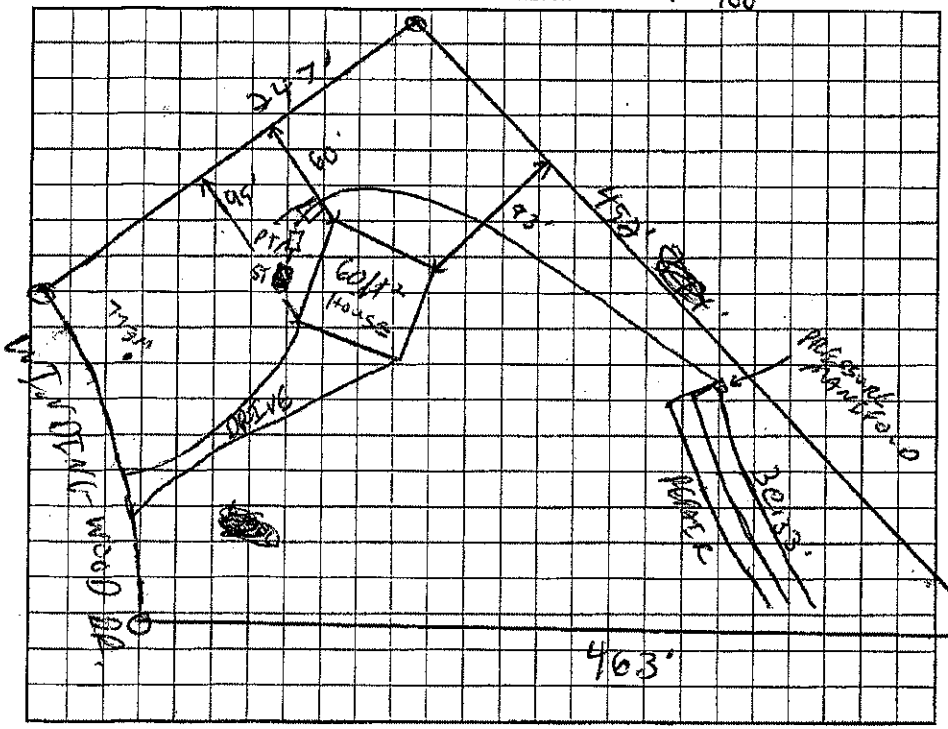

AS BUILT SKETCH

AS SHOWN

Permit can be suspended or revoked if any false information is supplied toward securing the permit/any unauthorized changes are made to the site/any unauthorized changes are made in the installation of the system. Improvement Permit with plat valid without expiration. Improvement Permit with site plan valid for sixty months. Authorization to Construct is valid for a period equal to that of Improvement Permit – not to exceed sixty months.

Signed: date 4/7/03 Installed by: SAMMY REAVIS

Improvement Permit by: date 3/28/03 Operation Permit by: STEVE HENDRICK date 3-22-07

Authorization to Construct by: date 4-20-06 Existing System Inspection by: date

HEALTH DEPT. COPY: WHITE OWNER COPY (FINAL): YELLOW OWNER COPY (INITIAL): PINK