IREDELL COUNTY HEALTH DEPARTMENT

STATESVILLE 704-878-5305 MOORESVILLE 704-664-5281

IMPROVEMENT PERMIT / AUTHORIZATION TO CONSTRUCT / OPERATION PERMIT / EXISTING SYSTEM INSPECTION

PERMIT# 91992 PIN# 4711 15 0730 DATE 9/28/00

OWNER OR CONTRACTOR Joe Keenan PHONE: Business Home (704) 528-1987

ADDRESS 305 Wagner ST Troutman NC 28166

LOCATION Buffalo Shoals, on Rt after Gray Rock Dr.

SUBDIVISION Gray Rock Shoals BLOCK / SECTION — LOT 45 LOT AREA 1.12 AC SITE CLASS PS DESIGN FLOW 360 L.T.A.R. 0.3

Septic Tank: 1000 Gallons: STB 1012 Date 9-16-2000

Pump Tank: Gallons; PT Date

Pump Make: Model Serial No.

Nitrification Field: No Fields 1 Square Feet 1200 Linear Feet 400

No Lines 5 Trench Width 36" Max Trench Bottom Depth 36" Gravel Depth 12

☒ New System ☐ Repair System Type: I. II. III. IV. V. VI

System Description: Gravity Conv.

Repair System Description: Grav. Conv.

Maintenance Agreement Required: ☐ Yes ☐ No

☒ House/Mod. Home ☐ Mobile Home ☐ Business ☐ Other

No. Bedrooms 3 No. Bathrooms 2 No. Employees


☐ Slab ☒ Crawl Space ☐ Basement w/plumbing ☐ Basement wo/plumbing

Water Supply: ☒ Individual ☐ Public ☐ Community


Comments/Conditions:

Comments/Conditions: INSTALLED USING POLY LOK FITER & WITH RISER.

INITIAL SITE SKETCH

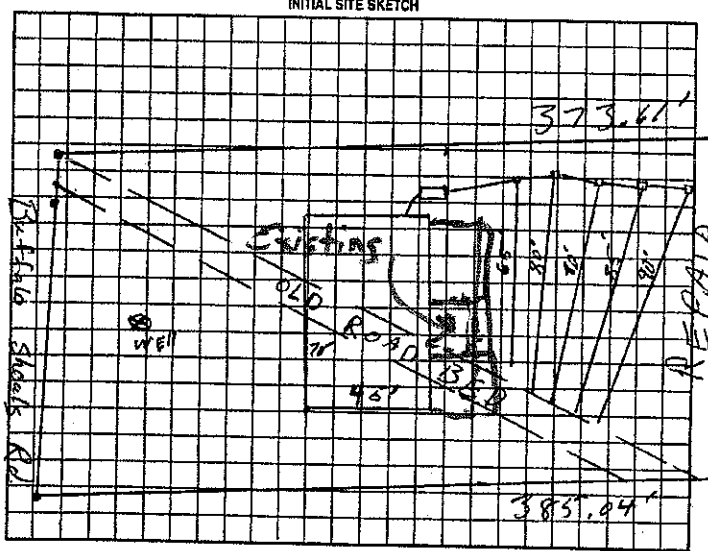

AS BUILT SKETCH

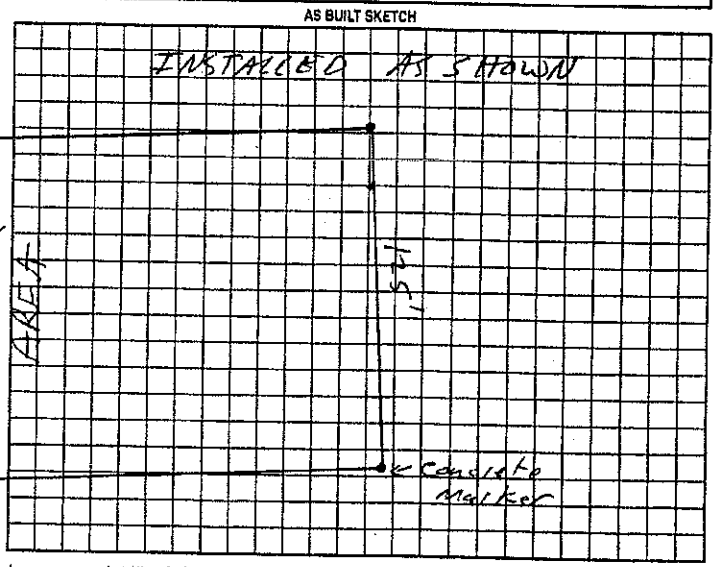

Permit can be suspended or revoked if any false information is supplied toward securing the permit/any unauthorized changes are made to the site/any unauthorized changes are made in the installation of the system. Improvement Permit with plat valid without expiration. Improvement Permit with site plan valid for sixty months. Authorization to Construct is valid for a period equal to that of Improvement Permit – not to exceed sixty months.

Signed: date 12/11/00 Installed by: Steve Jordan

Improvement Permit by: RST date 9/28/00 Operation Permit by: John Cook RST date 2-1-01

Authorization to Construct by: RST date 9/28/00 Existing System Inspection by: date

HEALTH DEPT. COPY: WHITE OWNER COPY (FINAL): YELLOW OWNER COPY (INITIAL): PINK