IREDELL COUNTY HEALTH DEPARTMENT

THIS PERMIT VOIDS PREVIOUS ISSUED 8-21-95

STATESVILLE 704-878-5305 MOORESVILLE 704-664-5281

IMPROVEMENT PERMIT / AUTHORIZATION TO CONSTRUCT / OPERATION PERMIT / EXISTING SYSTEM INSPECTION

PERMIT# 21854 / 74427 PIN# 4711 16 1136 DATE 7-19-2000

OWNER OR CONTRACTOR WILLIAM HOOKER PHONE: Business 682-1270 Home (828) 241-9226

ADDRESS 131 GRAYROCK DRIVE STATESVILLE NC 28677

LOCATION BUFFALO SHOALS ROAD, TR 1 GRAYROCK DRIVE, 2ND LOT ON LEFT

SUBDIVISION GRAYROCK BLOCK / SECTION ____ LOT 41 LOT AREA 1.1961 ACRES SITE CLASS PS DESIGN FLOW 360 L.T.A.R. 0.30 GPD/FT²

Septic Tank: 1000 Gallons; STB 1004 Date 6-26-00

Pump Tank: ____ Gallons; PT ____ Date ____

Pump Make: ____ Model ____ Serial No. ____

Nitrification Field: No Fields 1 Square Feet 1200 Linear Feet 400

No Lines FOUR Trench Width 36" Max Trench Bottom Depth 32"

☑ New System ☐ Repair System Type: I II III IV V VI

System Description: CONVENTIONAL GRAVITY

Repair System Description: CONV. GRAVITY

Maintenance Agreement Required: ☐ Yes ☐ No

Gravel Depth 12" ☐ Slab ☑ Crawl Space ☐ Basement w/plumbing ☒ Basement wo/plumbing

☑ House/Mod. Home No. Bedrooms 3

☐ Mobile Home No. Bathrooms 2½

☐ Business No. Employees ____

☐ Other ____


Water Supply: ☑ Individual ☐ Public ☐ Community

WELL


Comments:/Conditions:

Comments /Conditions: SEPTIC TANK W/ RISERS INSTALLED USING "POLYLOK" FILTER

INITIAL SITE SKETCH SCALE: 1"=50'

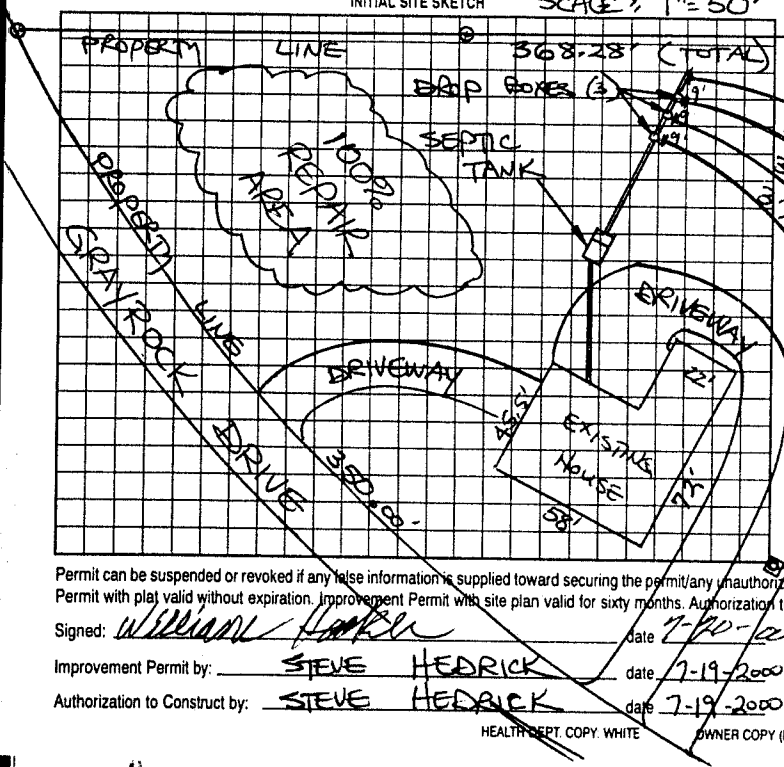

AS BUILT SKETCH

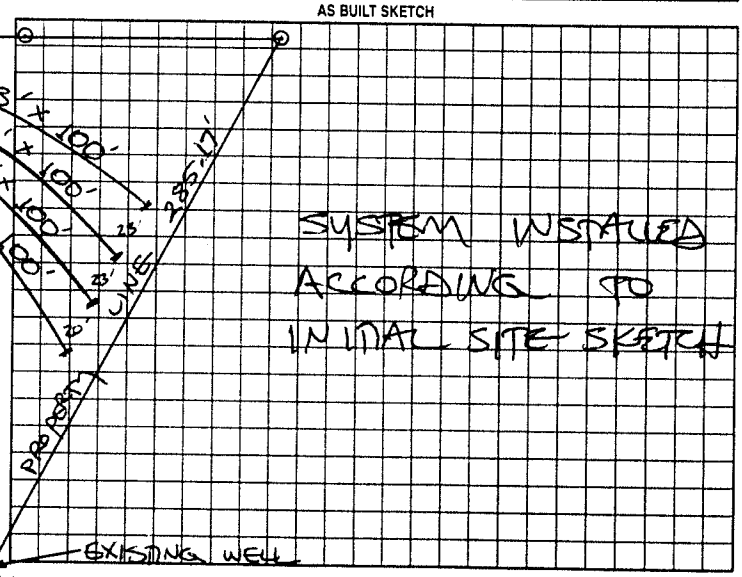

Permit can be suspended or revoked if any false information is supplied toward securing the permit/any unauthorized changes are made to the site/any unauthorized changes are made in the installation of the system. Improvement Permit with plat valid without expiration. Improvement Permit with site plan valid for sixty months. Authorization to Construct is valid for a period equal to that of Improvement Permit – not to exceed sixty months.

Signed: William Hooker date 7-20-00 Installed by: JODY TRAVIS

Improvement Permit by: STEVE HEDRICK date 7-19-2000 Operation Permit by: STEVE HEDRICK date 8-18-00

Authorization to Construct by: STEVE HEDRICK date 7-19-2000 Existing System Inspection by: ____ date ____

HEALTH DEPT. COPY: WHITE OWNER COPY (FINAL): YELLOW OWNER COPY (INITIAL): PINK