IREDELL COUNTY HEALTH DEPARTMENT

STATESVILLE 704-878-5305 @ Spring MOORESVILLE 704-664-5281

IMPROVEMENT PERMIT / AUTHORIZATION TO CONSTRUCT / OPERATION PERMIT / EXISTING SYSTEM INSPECTION

PERMIT # 158659 PIN # 4711-16-2489 DATE 28 April 10

OWNER or APPLICANT G. Scott Hammond PHONE: ~~Business~~ (704) 528-1203 Home:

OWNER or APPLICANT ADDRESS 156 Craigrock Dr. Statesville

LOCATION / DIRECTIONS Old mtn. Rd. Turn onto Buffalo Shoals Rd. TR Craigrock Dr. Lot #5 on Rt.

SUBDIVISION Craigrock Shoals BLOCK / SECTION LOT # 5 LOT AREA 1.23ac. DESIGN FLOW 480gpd L.T.A.R. 0.3 gpd/ft²

Septic Tank 1000 Gallons: STB 1012 Date 4-20-10
Pump Tank Gallons: P.T. Date
Pump Make Model Serial #
Nitrification Field No Fields 1 No Lines 5 Linear Feet 400
Trench Width 36" Max. Trench Bottom Depth 36" Gravel Depth N/A

☑ New System ☐ Repair ☐ Expansion System Type I II (III) IV V VI
System Description: 250g Reduction
Repair System Description: 500g Reduction w/ LPP
Maintenance Agreement Required ☐ YES ☑ NO
☑ GRAVITY ☐ PRESSURE


☑ Residence No. Bedrooms 4
☐ Business No. Persons
☐ Other No. Employees
☐ Slab ☐ Crawl Space
☑ Basement w/plumbing ☐ Basement w/o plumbing

Water Supply: ☑ Private ☐ Public ☐ Community


Comments / Conditions: Follow engineer. Avoid old road bed.

Comments / Conditions: Polylock Filter / ST has riser

INITIAL SITE SKETCH

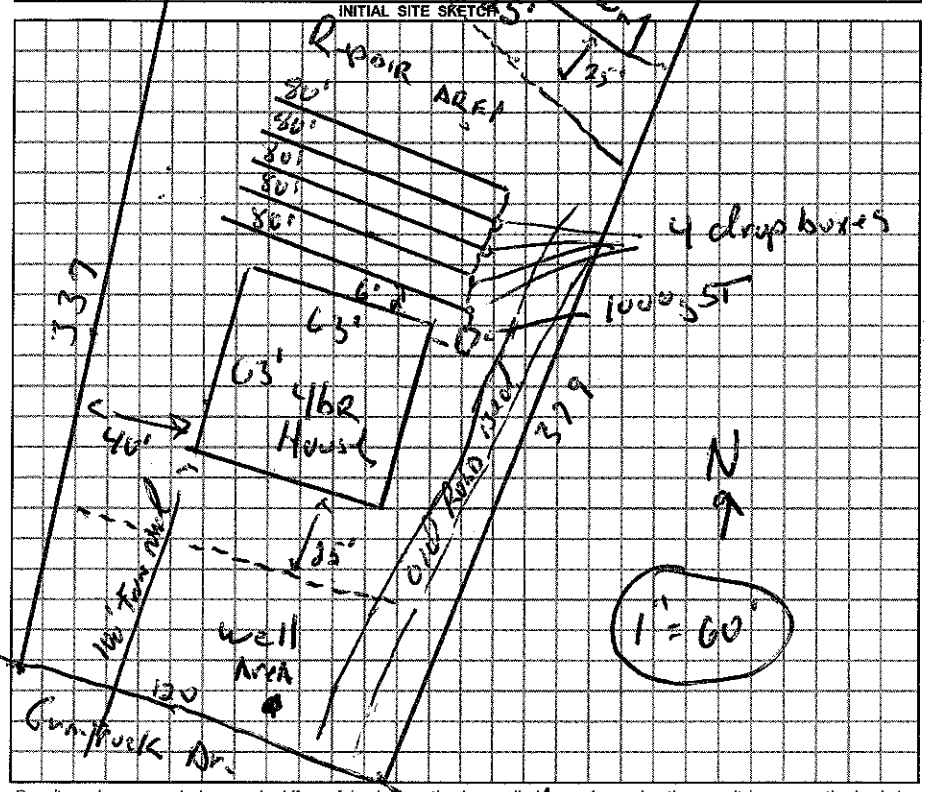

AS BUILT SKETCH

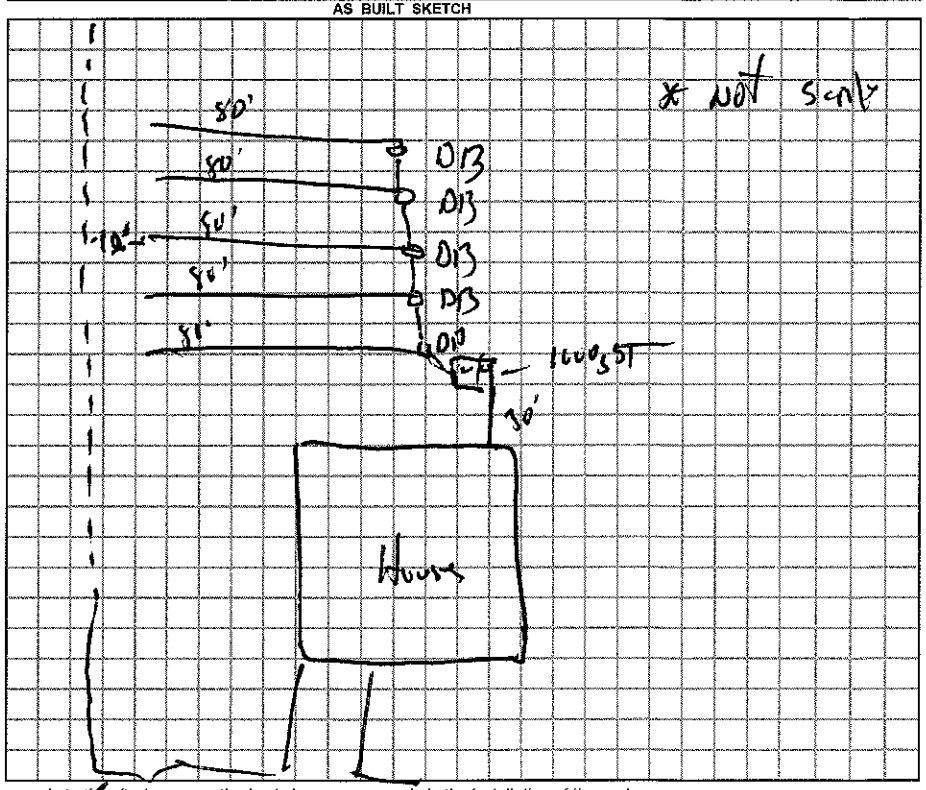

Permit can be suspended or revoked if any false information is supplied toward securing the permit / any unauthorized changes are made to the site / any unauthorized changes are made in the installation of the system.

☐ *IMPROVEMENT PERMIT w / plat valid without expiration.* ☑ *IMPROVEMENT PERMIT w / site plan valid for 60 mos.* ☑ *AUTHORIZATION TO CONSTRUCT valid for period equal to IMPROVEMENT PERMIT-not to exceed 60 mo.*

Owner / Applicant Signature: Date 5/7/10

Improvement Permit by: R.S. Date 28 Apr 10

Authorization to Construct by: R.S. Date 28 Apr 10

YOU SHOULD CONTACT A LOCATOR SERVICE PRIOR TO ANY EXCAVATION.

Installed by: Vaught

Operation Permit by: R.S. Date: 2 November 10

Existing System Inspected by: Date:

WHITE COPY Environmental Health YELLOW COPY (Final) Owner / Applicant PINK COPY (Initial) Owner / Applicant