IREDELL COUNTY HEALTH DEPARTMENT

STATESVILLE 704-878-5305 MOORESVILLE 704-664-5281

IMPROVEMENT PERMIT / AUTHORIZATION TO CONSTRUCT / OPERATION PERMIT / EXISTING SYSTEM INSPECTION

PERMIT# 17237 PIN# 4714 16 4435 DATE 10-17-98

OWNER OR CONTRACTOR High Shoales Development PHONE: Business 873-2121 Home

ADDRESS 1805 Safrit Rd Statesville, N.C.

LOCATION Buffalo Shoales TR Grayrock 500' Rt.

SUBDIVISION Gray Rock BLOCK / SECTION LOT 4 LOT AREA 1.49 acres SITE CLASS PS DESIGN FLOW 360 L.T.A.R. .3

Septic Tank: 1000 Gallons: STB 1007 Date 3/7/2000
Pump Tank: Gallons: PT Date
Pump Make: Model Serial No
Nitrification Field: No Fields 1 Square Feet 1200 Linear Feet 400
No Lines 3 Trench Width 36" Max Trench Bottom Depth 36"

☒ New System ☐ Repair System Type I II III IV V VI
System Description: Conv. Gravity
Repair System Description: Pump To Chambers
Maintenance Agreement Required ☐ Yes ☒ No 25% Rule


☒ House/Mod. Home No. Bedrooms 3
☐ Mobile Home No. Bathrooms 2
☐ Business No. Employees
☐ Other
☐ Slab ☐ Crawl Space ☐ Basement w/plumbing ☐ Basement w/o plumbing

Water Supply: ☒ Individual ☐ Public ☐ Community


Comments/Conditions:

Comments/Conditions: * 4" Sch 40 Used from Home To Tank placed under Drive To Comply. Sch 40 135' Allow

INITIAL SITE SKETCH

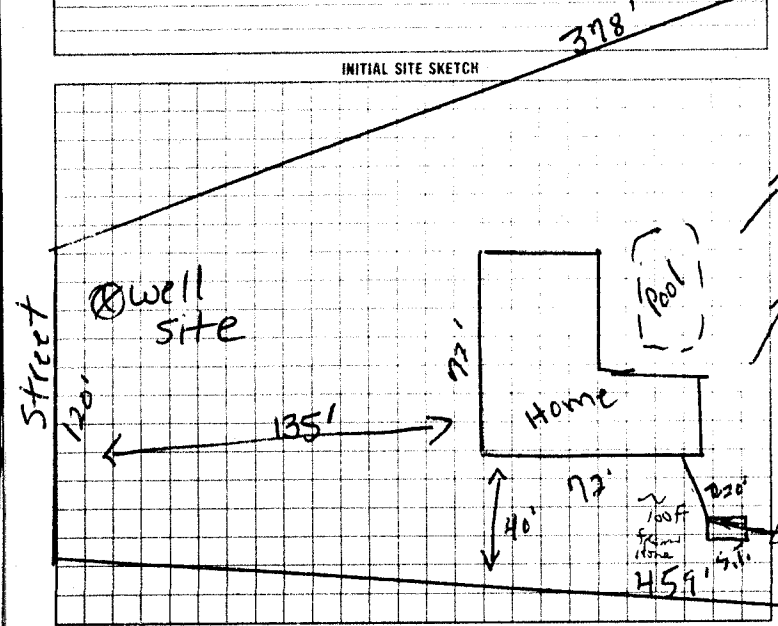

AS BUILT SKETCH

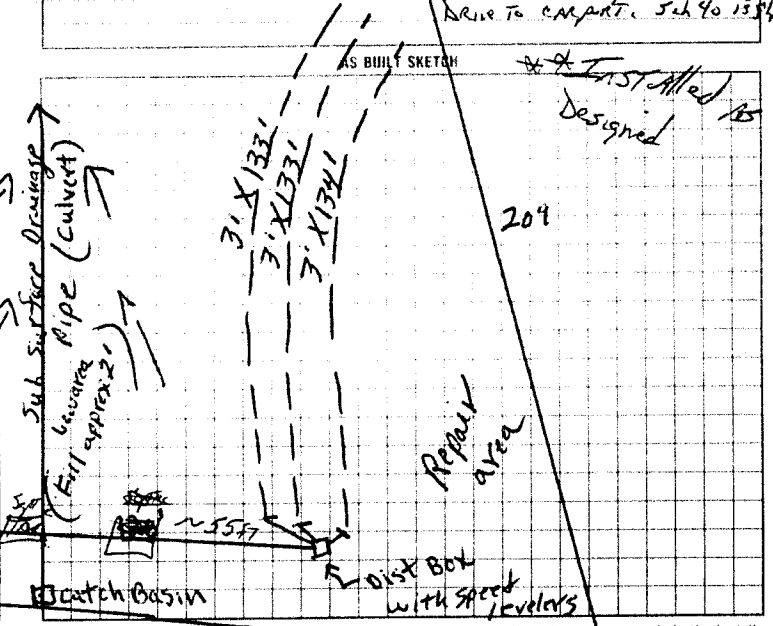

I understand that this permit can be suspended or revoked if any false information is supplied toward securing the permit/any unauthorized changes are made to the site/any unauthorized changes are made in the installation of the system. Improvement Permit with plat valid without expiration. Improvement Permit with site plan valid for sixty months. Authorization to Construct is valid for a period equal to that of Improvement Permit – not to exceed sixty months.

Signed: C. A. [illegible] VP date 10-21-98 Installed by: Travis Enterprise

Improvement Permit by: P. C. Moore date 10-17-98 Operation Permit by: [illegible] Potter date May 3 2000

Authorization to Construct by: P. C. Moore date 10-17-98 Existing System Inspection by: date

HEALTH DEPT. COPY: WHITE INSPECTION COPY (FINAL): GREEN OWNER COPY (FINAL): YELLOW INSPECTION COPY (INITIAL): PINK OWNER COPY (INITIAL): GOLD