IREDELL COUNTY HEALTH DEPARTMENT

STATESVILLE 704-878-5305 MOORESVILLE 704-664-5281

IMPROVEMENT PERMIT / AUTHORIZATION TO CONSTRUCT / OPERATION PERMIT / EXISTING SYSTEM INSPECTION

PERMIT# 97236 PIN# 4711 14 6276 DATE 10-17-98

OWNER OR CONTRACTOR High Shoals Develop PHONE: Business 873 2121 Home

ADDRESS 1805 Sabrina Rd Sta. NC

LOCATION Buffalo Shoals Jr Graystock on Rt

SUBDIVISION Graystock BLOCK / SECTION LOT 2 LOT AREA 1.3677 acres SITE CLASS. PS DESIGN FLOW 360 L.T.A.R. .3

Septic Tank: 1000 Gallons; STB 794 Date 6799

Pump Tank: Gallons; PT Date

Pump Make: Model Serial No.

Nitrification Field: No Fields 1 Square Feet 1200 Linear Feet 400

No Lines 3 Trench Width 36" Max Trench Bottom Depth 36" Gravel Depth 12"

[x] New System [ ] Repair System Type: [I] II, III, IV, V, VI

System Description: Conv. Gravity

Repair System Description:

Maintenance Agreement Required: [ ] Yes [x] No

[x] House/Mod. Home No. Bedrooms 3

[ ] Mobile Home No. Bathrooms 2

[ ] Business No. Employees

[ ] Other


[ ] Slab [ ] Crawl Space [x] Basement w/plumbing [ ] Basement wo/plumbing

Water Supply: [x] Individual [ ] Public [ ] Community


Comments:/Conditions:

Comments:/Conditions:

INITIAL SITE SKETCH

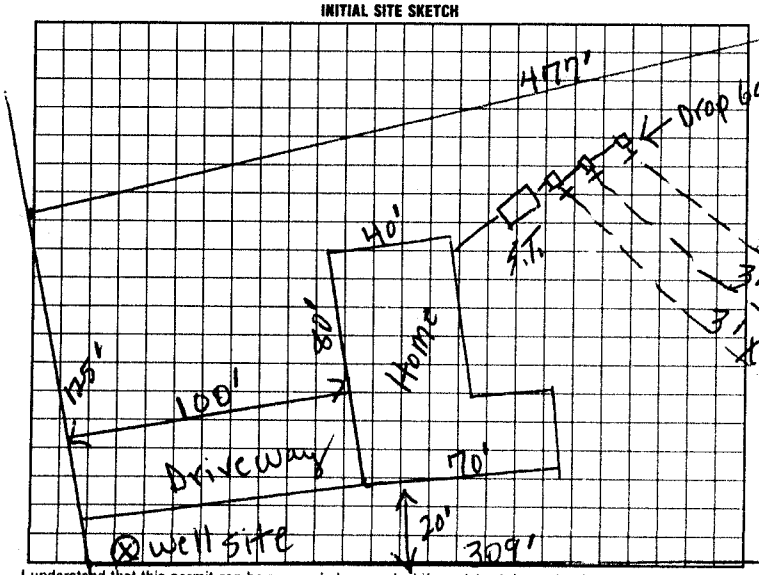

AS BUILT SKETCH

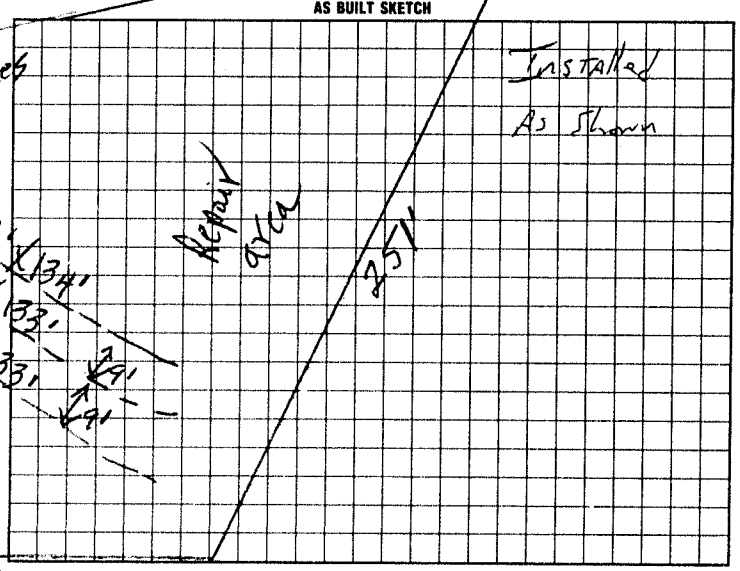

I understand that this permit can be suspended or revoked if any false information is supplied toward securing the permit/any unauthorized changes are made to the site/any unauthorized changes are made in the installation of the system. Improvement Permit with plat valid without expiration. Improvement Permit with site plan valid for sixty months. Authorization to Construct is valid for a period equal to that of Improvement Permit – not to exceed sixty months.

Signed: [signature] date Installed by: Tucker Hauling & Grading

Improvement Permit by: P.C. Moore date 10-17-98 Operation Permit by: [signature] date 9-8-99

Authorization to Construct by: P.C. Moore date 10-17-98 Existing System Inspection by: date

HEALTH DEPT. COPY: WHITE INSPECTION COPY (FINAL): GREEN OWNER COPY (FINAL): YELLOW INSPECTION COPY (INITIAL): PINK OWNER COPY (INITIAL): GOLD