IREDELL COUNTY HEALTH DEPARTMENT

STATESVILLE 704-878-5305 (CF) MOORESVILLE 704-664-5281

IMPROVEMENT PERMIT / AUTHORIZATION TO CONSTRUCT / OPERATION PERMIT / EXISTING SYSTEM INSPECTION

PERMIT# 118365 PIN# 4711-20-0460 DATE 4-12-04

OWNER OR CONTRACTOR GARY WOOD PHONE: Business Home 704-634-3751

ADDRESS 600 Union West Matthews NC 28104

LOCATION BUFF SHOALS WEST (E) LAUREL COVE (R) HARBOR GATE (R) HARBOR WATCH (L) HARBOR RIDGE (L) HARBOR CLIFF @ END IN CUL-DE SAC

SUBDIVISION HARBOR WATCH BLOCK / SECTION 7 LOT 135 LOT AREA 1.41AC SITE CLASS PS DESIGN FLOW 360 L.T.A.R. .3

Septic Tank: 1000 Gallons; STB 794 Date 12-13-04

Pump Tank: 1000 Gallons; PT 283 Date 12-14-04

Pump Make: MYERS Model M-505-1 Serial No. 25325007

Nitrification Field: No Fields 1 Square Feet EQ=1200' Linear Feet 300'

No Lines 4X25 Trench Width 36" Max Trench Bottom Depth 36" Gravel Depth N/A

☒ New System ☐ Repair System Type: I, II, ☐ III, IV, V, VI

System Description: PUMP 250 GAL RED

Repair System Description: LP PANEL

Maintenance Agreement Required: ☐ Yes ☒ No

☒ House/Mod. Home ☐ Mobile Home ☐ Business ☐ Other

No. Bedrooms 3 No. Bathrooms 4 No. Employees


☐ Slab ☐ Crawl Space ☒ Basement w/plumbing ☐ Basement wo/plumbing

Water Supply: ☒ Individual ☐ Public ☐ Community


Comments:/Conditions: (1) SEE ATTACHED SURVEYED PLAT WHICH IS TO SCALE. LINES FLAGGED OUT & HOUSE SITE SURVEYED OUT. 760'/50' SETBACK SURVEYED OFF ALSO, (2) INSTALL LINES ON CONTOURS & MAINTAIN SETBACKS (3) SLOPE

Comments:/Conditions: EXCEEDS OR EQUALS 40%, MUST BE INSTALLED ACCORDING TO 15A NCAC 18A .1956 (5)(A,B,C), (4) NEED BASEMENT LOT SO TANK LOCATIONS & SETBACKS CAN BE MAINTAINED (5) CALL PRIOR TO INSTALLATION FOR PUMP SIZING & SPECS. IF NECESSARY

"NOT TO SCALE" INITIAL SITE SKETCH

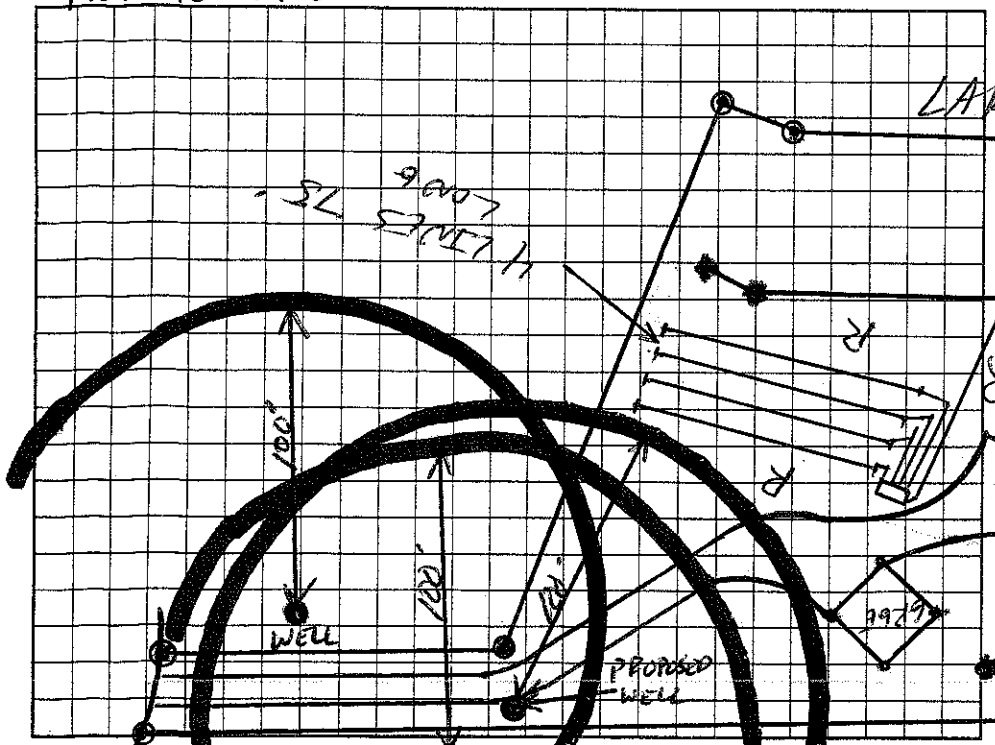

AS BUILT SKETCH

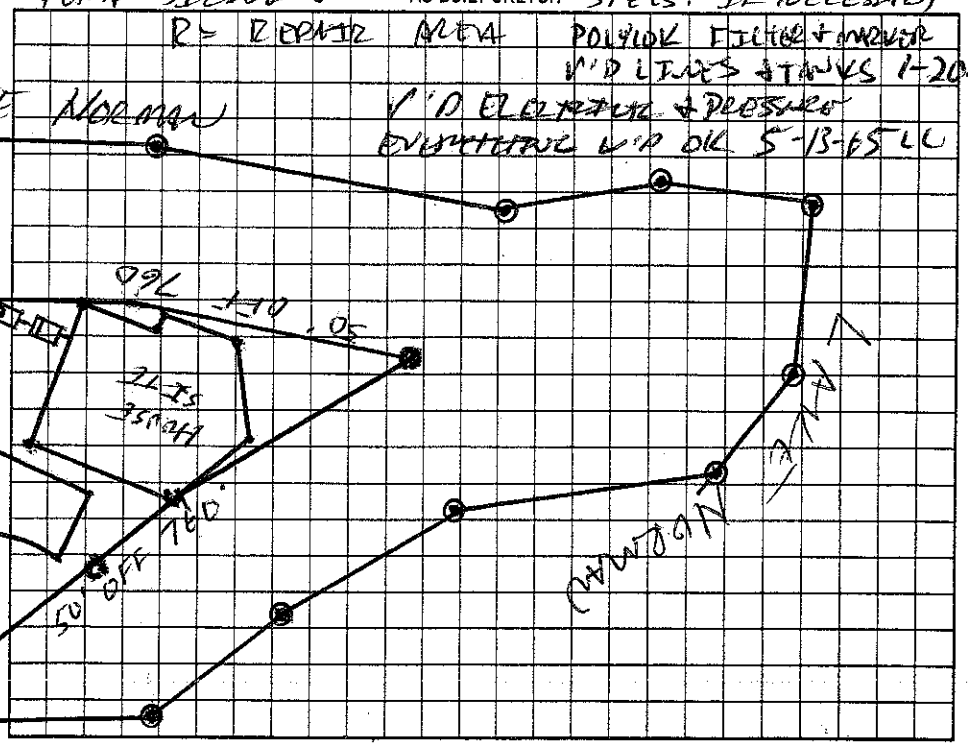

Permit can be suspended or revoked if any false information is supplied toward securing the permit/any unauthorized changes are made to the site/any unauthorized changes are made in the installation of the system. Improvement Permit with plat valid without expiration. Improvement Permit with site plan valid for sixty months. Authorization to Construct is valid for a period equal to that of Improvement Permit – not to exceed sixty months.

Signed: G Wood date

Improvement Permit by: [signature] date 4-12-04

Authorization to Construct by: [signature] date 4-12-04

Installed by: PERRY LAWEY

Operation Permit by: [signature] date 5-13-05

Existing System Inspection by: date

HEALTH DEPT. COPY: WHITE OWNER COPY (FINAL): YELLOW OWNER COPY (INITIAL): PINK