135 Hse to Plc 105 Exp + plc 56. 58' TANK IS 100' From P/L

THIS PERMIT VOIDS PREVIOUS ISSUED 9-23-06

IREDELL COUNTY HEALTH DEPARTMENT

STATESVILLE 704-878-5305 CI MOORESVILLE 704-664-5281

IMPROVEMENT PERMIT / AUTHORIZATION TO CONSTRUCT / OPERATION PERMIT / EXISTING SYSTEM INSPECTION

PERMIT# 1366601 PIN# 4711-20-6392 DATE 3-20-08

OWNER OR APPLICANT SCOTT CREAMER PHONE: Business ~~704-200-4165~~ 336-817-1569 Home % 336-345-5302

ADDRESS 210 JUNIPER CIRCLE, ADVANCE, NC

LOCATION BUFFALO SHOALS ROAD, TL LAUREL COVE ROAD, TR HARBOR GATE DR, TL HARBOR WATCH DR, LOT # 37 ON RIGHT

SUBDIVISION HARBOR WATCH BLOCK / SECTION I LOT 37 LOT AREA 0.779 ACRE SITE CLASS PS DESIGN FLOW 600 L.T.A.R. 0.30 GAD/Ft²

1882 1500

Septic Tank: 1500 Gallons: STB 2109 Date 8-20-06

Pump Tank: 1500 Gallons: PT 201 Date 2-26-08

Pump Make: _____ Model _____ Serial No. _____

Nitrification Field: No Fields 1 Square Feet EQ.PP 2000 Linear Feet 333

No Lines FOUR Trench Width 24" Max Trench Bottom Depth 36" ~~Min~~ Depth 24"

☑ New System ☐ Repair ☐ Expansion System Type: I II III IV V VI

System Description: 50% REDUCTION, LOW-PRESSURE

Repair System Description: 50% REDUCTION, LOW-PRESSURE

Maintenance Agreement Required: ☑ Yes ☐ No

☑ House/Mod. Home ☐ Mobile Home ☐ Business ☐ Other

No. Bedrooms 5 No. Persons ____ No. Employees ____

Water Supply: ☑ Individual ☐ Public ☐ Community WELL


☐ Gravity ☑ Pressure ☐ Slab ☐ Crawl Space ☑ Basement w/plumbing ☐ Basement wo/plumbing

Comments/Conditions: ① KEEP SYSTEM MINIMUM 50' FROM WELL ② INSTALL 50% REDUCTION SYSTEM ON CONTOUR USING 76 PPBPS PANELS. ③ SEE ATTACHED SHEETS FOR PUMP & LOW-PRESSURE DISTRIBUTION REQUIREMENTS & SIDE ELEVATION DIAGRAM

Comments/Conditions: ④ A CONTRACT BETWEEN A CERTIFIED MAINTENANCE OPERATOR & THE SYSTEM OWNER SHALL BE EXECUTED PRIOR TO ISSUANCE of OPERATION PERMIT. BOWED Filter & manifold


HARBOR WATCH DRIVE

INITIAL SITE SKETCH

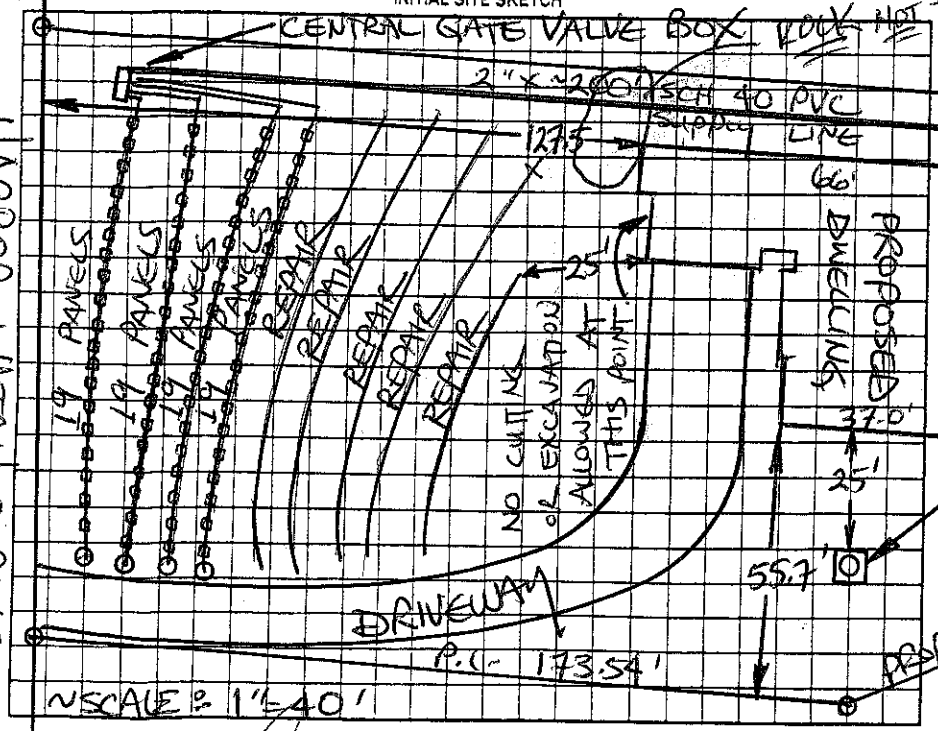

AS BUILT SKETCH

HOT TO SCALE 10-8-08

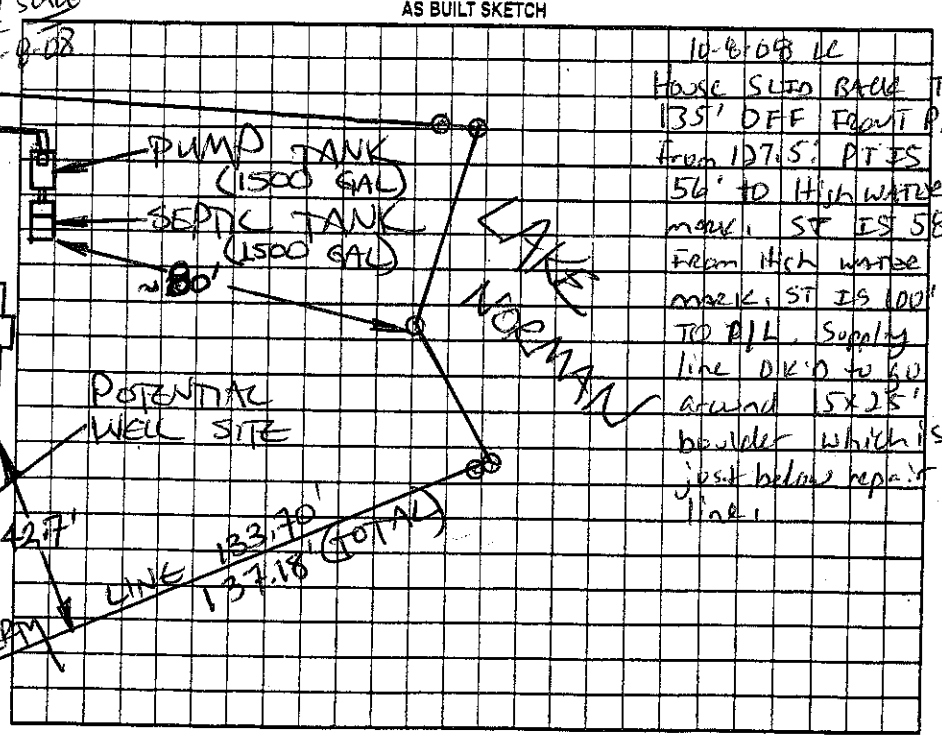

10-8-08 LC
HOUSE SLID BACK TO 135' OFF FRONT P/L From ID 7.5. PTES 56' TO High WATER mark. ST IS 58' From High water mark. ST IS 100' TO P/L. Supply line DIG'D to KO around 15x25' boulder which is just below repair line.

Permit can be suspended or revoked if any false information is supplied toward securing the permit/any unauthorized changes are made to the site/any unauthorized changes are made in the installation of the system. Improvement Permit with plat valid without expiration ☐ Improvement Permit with site plan valid for sixty months ☑ Authorization to Construct is valid for a period equal to that of Improvement Permit – not to exceed sixty months.

Signed: _____ date 3/20/08

Improvement Permit by: STEVE HENDRICK date 3-20-08

Authorization to Construct by: STEVE HENDRICK date 3-20-08

Installed by: Tommy Cothran

Operation Permit by: _____ date 11/25/08

Existing System Inspection by: _____ date _____

HEALTH DEPT. COPY: WHITE OWNER COPY (FINAL): YELLOW OWNER COPY (INITIAL): PINK

HARBOR WATCH DRIVE