IREDELL COUNTY HEALTH DEPARTMENT

CI

STATESVILLE 704-878-5305 MOORESVILLE 704-664-5281

IMPROVEMENT PERMIT / AUTHORIZATION TO CONSTRUCT / OPERATION PERMIT / EXISTING SYSTEM INSPECTION

PERMIT# 122611 PIN# 4711-20-8535 DATE 1-20-06

OWNER OR CONTRACTOR Hopkins & Hopkins Const. PHONE: Business 704 875 0640 Home

ADDRESS 209 S. Harbor Watch Rd

LOCATION Buffalo Shoals, (L) Laurel Cove Rd (R) Harbor Watch (L) South Harbor Watch on (R)

SUBDIVISION Harbor Watch BLOCK / SECTION 1 LOT 34 LOT AREA 1.42 Acre SITE CLASS. PS DESIGN FLOW 360 L.T.A.R. .3

Septic Tank: 1000 Gallons; STB 312 Date 2-6-06

Pump Tank: 1000 Gallons; PT Date 2-9-06

Pump Make: Model Serial No.

Nitrification Field: No Fields 1 Square Feet 1600 Linear Feet 400'

No Lines 4 Trench Width 36" Max Trench Bottom Depth 36" Gravel Depth 12"

☒ New System ☐ Repair System Type: I, II, III, IV, V, VI

System Description: Pump conventional

Repair System Description: Pump LP 50% Reduction

Maintenance Agreement Required: ☐ Yes ☒ No

☒ House/Mod. Home No. Bedrooms 3 (3)

☐ Mobile Home No. Bathrooms 3

☐ Business No. Employees

☐ Other

☐ Slab ☐ Crawl Space ☒ Basement w/plumbing ☐ Basement wo/plumbing


Water Supply: ☒ Individual ☐ Public ☐ Community

Comments:/Conditions: (An approved systeim (25% reduction) is also acceptable)


Sleeve supply line when lines traverses under driveway

Comments:/Conditions:

INITIAL SITE SKETCH

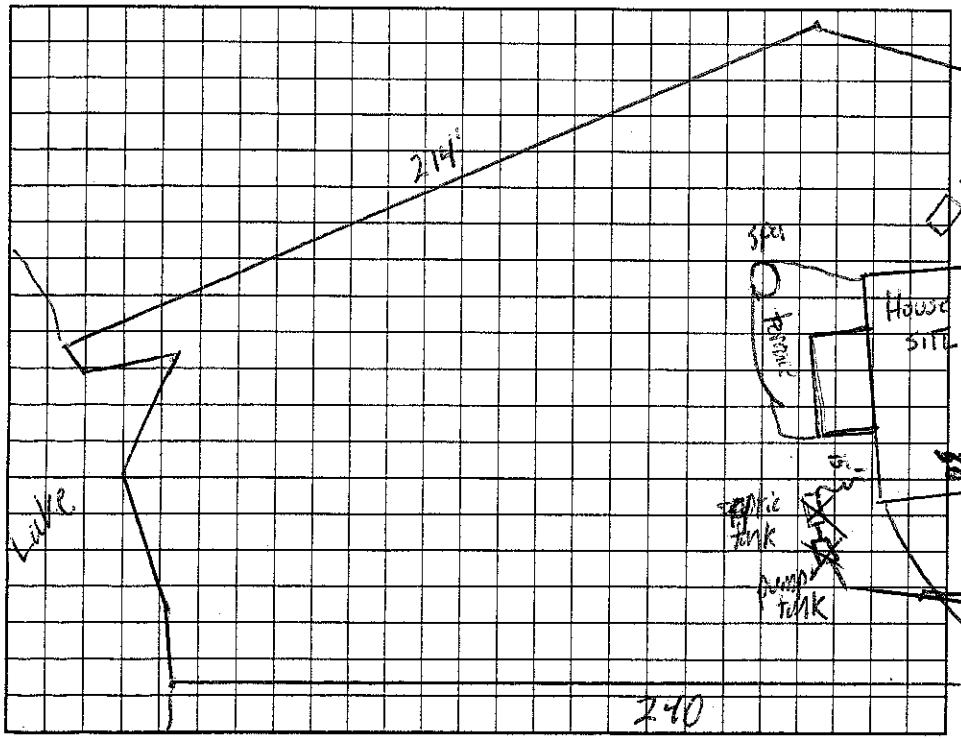

AS BUILT SKETCH

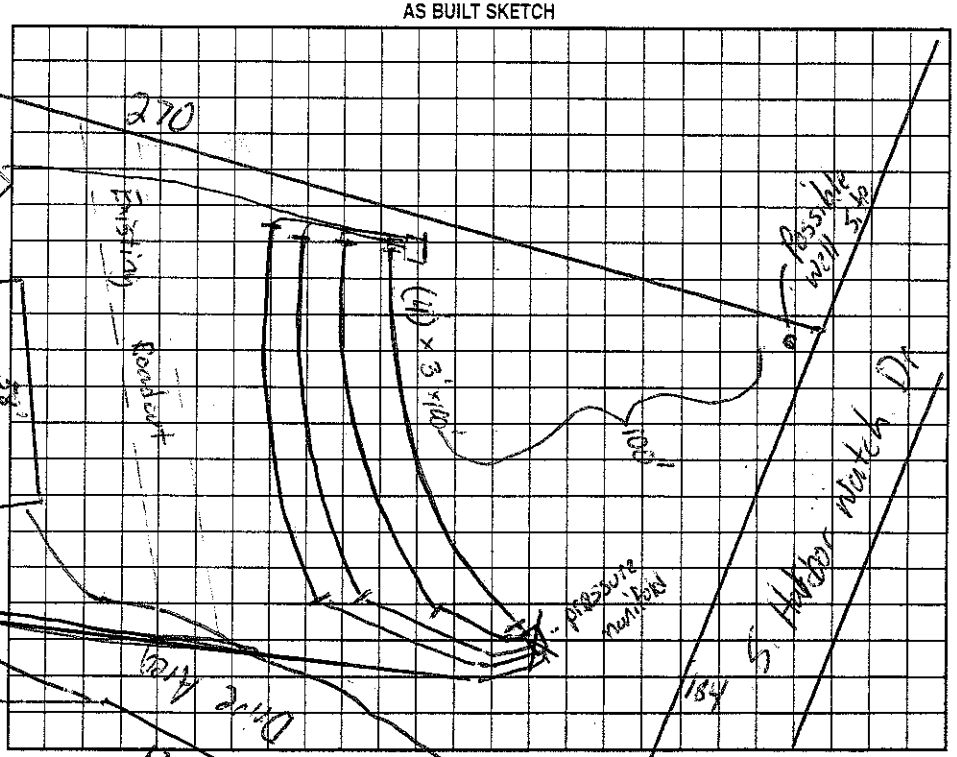

Permit can be suspended or revoked if any false information is supplied toward securing the permit/any unauthorized changes are made to the site/any unauthorized changes are made in the installation of the system. Improvement Permit with plat valid without expiration. Improvement Permit with site plan valid for sixty months. Authorization to Construct is valid for a period equal to that of Improvement Permit – not to exceed sixty months.

Signed: date 1-20-06 Installed by: Larry Tucker construction

Improvement Permit by: James Hopkins date 1-20-05 Operation Permit by: James Hopkins date 1-23-07

Authorization to Construct by: James Hopkins date 1-20-05 Existing System Inspection by: date

HEALTH DEPT. COPY: WHITE OWNER COPY (FINAL): YELLOW OWNER COPY (INITIAL): PINK